

PIKE
F 2018
3-18-78

MISSISSIPPI
 BOARD OF WATER COMMISSIONERS
 416 North State Street
 Jackson, Mississippi 39201

WATER WELL DRILLERS LOG

March 18, 1978 *Reves Well No* *Pike*
 date well completed firm name county well located

LANDOWNER:
Mary Hill Church
At Summit
 (mailing address)

description of formations encountered	from	to
<i>clay</i>	<i>0</i>	<i>20</i>
<i>Red sand</i>	<i>20</i>	<i>80</i>
<i>Red sandy loam</i>	<i>80</i>	<i>120</i>
<i>Coarse sand</i>	<i>120</i>	<i>145</i>


WELL LOCATION:
 sec *5* T *3* N R *9* E
3 miles *S-SW* of *Price Dale*
 (distance) (direction) (nearest town)

WELL PURPOSE: *Church*
 (home, irrigation, municipal, industrial)

- WELL COMPLETION DATA:
- diameter (inches) *1 1/2"*
 - total depth (feet) *145*
 - static water level (feet) *90* below above top of ground.
 - casing *plastic* bottom (material) (depth)
 - screen *5"* *140* (length) (depth to top)
 - pump *4"* *plastic* (size) (material)
 - pump *1/2* *10* (HP) (yield gpm)
 - electric log *flut* (type power)
 - electric log *no* (yes or no)
 - (organization running log)

(8) how well bottom plugged:
Wooden Plug

DRILLERS REMARKS:
[Signature]

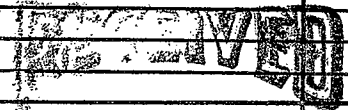


JUN - 8 1978

MISS. BD. OF WATER COMM

If well telescopes please sketch and show depths.

GROUND LEVEL

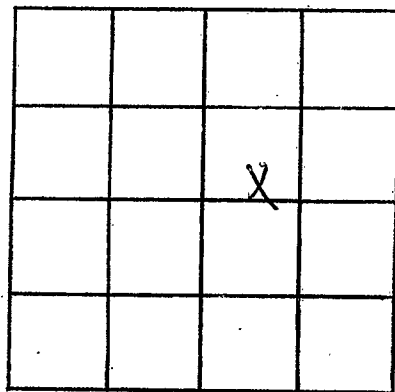

SECTION _____

Please indicate well location X.

ADDITIONAL INFORMATION

If more than one screen, show locations of each on sketch.