

PIKE
F 2001
8-22-78

**MISSISSIPPI
BOARD OF WATER COMMISSIONERS**
416 North State Street
Jackson, Mississippi 39201

WATER WELL DRILLERS LOG

8-22 1978 Fitzwell Well Co Pike
 date well completed firm name county well located

LANDOWNER:
W. J. Montgomery
P.O. Summit ms
 (mailing address)

description of formations encountered	from to	
	feet	feet
<u>Red clay</u>	<u>0</u>	<u>20</u>
<u>Red sand</u>	<u>20</u>	<u>80</u>
<u>Red white chlk</u>	<u>80</u>	<u>140</u>
<u>Lower sand & gravel</u>	<u>140</u>	<u>153</u>

WELL LOCATION:
 sec. 11 T-3 N R-9 E
 S W
10 miles E of McComb
 (distance) (direction) (nearest town)

WELL PURPOSE: Home
 (home, irrigation, municipal, industrial)

WELL COMPLETION DATA:

(1) diameter (inches) 4

(2) total depth (feet) 153

(3) static water level (feet) 20 below above top of ground.

(4) casing PVC, 145,
 (material) (depth)
4 If telescope see back.
 (size)


(5) screen 8, 145
 (length) (depth to top)
4, PVC
 (size) (material)

(6) pump 1/2, 10
 (HP) (yield gpm)
Elec
 (type power)

(7) electric log yes
 (yes or no)
 (organization running log)

(8) how well bottom plugged Seal shell


DRILLERS REMARKS:

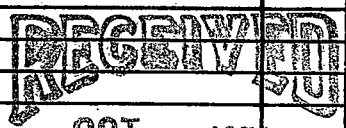

OCT 3 1978

If well telescopes please sketch and show depths.

GROUND LEVEL

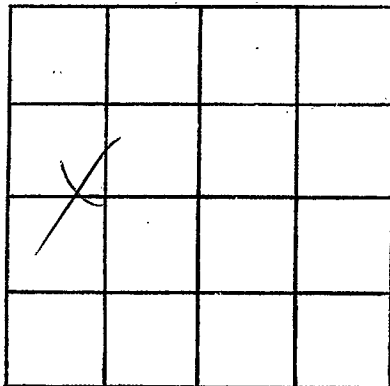

SECTION 11

Please indicate well location X.

ADDITIONAL INFORMATION

If more than one screen, show locations of each on sketch.