

PIKE
F <i>2022</i>
6-20-78

**MISSISSIPPI
BOARD OF WATER COMMISSIONERS**
416 North State Street
Jackson, Mississippi 39201

WATER WELL DRILLERS LOG

June 20 19*78* *Rivers Well Co.* *Pike*
 date well completed firm name county well located

LANDOWNER:	description of formations encountered	from	to
<i>Nacelle Thornton</i> <i>173 Sycamore</i> (mailing address)	<i>Red sandy clay</i> <i>Red sand</i> <i>sand gravel</i> <i>fine sand</i> <i>+ pebbles</i> <i>med. coarse sand</i>	<i>0</i> <i>27</i> <i>96</i> <i>110</i> <i>150</i>	<i>27</i> <i>96</i> <i>110</i> <i>150</i> <i>170</i>
WELL LOCATION: sec. <i>11</i> T. <i>3</i> N R. <i>9</i> E <i>3 1/2</i> miles <i>S-SE</i> of <i>piccola</i> (distance) (direction) (nearest town)			
WELL PURPOSE: <i>home</i> (home, irrigation, municipal, industrial)			
WELL COMPLETION DATA:			
(1) diameter (inches) <i>4"</i>			
(2) total depth (feet) <i>170</i>			
(3) static water level (feet) <i>127</i> below top of ground.			
(4) casing <i>plastic bottom</i> (material) (depth)			
_____ (size) if telescope see back.			
(5) screen <i>5'</i> <i>165'</i> (length) (depth to top)			
_____ (size) <i>plastic</i> (material)			
(6) pump <i>3/4</i> <i>12</i> (HP) (yield gpm)			
_____ (type power)			
(7) electric log <i>no</i> (yes or no)			
_____ (organization running log)			
(8) how well bottom plugged <i>wooden plug</i>			
DRILLERS REMARKS: <i>[Signature]</i>			


RECEIVED

OCT 25 1978

MISS. BD. OF WATER COMMISSIONERS

If well telescopes please sketch and show depths.

GROUND LEVEL

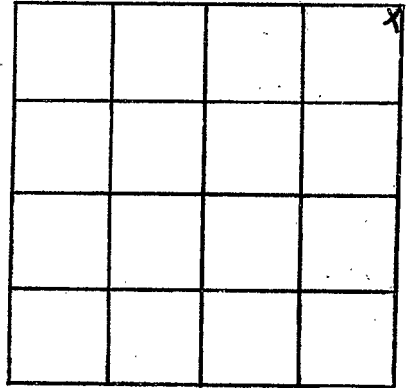

SECTION 11

Please indicate well location X.

ADDITIONAL INFORMATION

If more than one screen, show locations of each on sketch.