

PIKE
F 2024
9-28-78

**MISSISSIPPI  
BOARD OF WATER COMMISSIONERS**  
416 North State Street  
Jackson, Mississippi 39201

**WATER WELL DRILLERS LOG**

Sept 28 19 78 Reeves Miller Pike  
 date well completed firm name county well located

**LANDOWNER:**  
Edward Carr  
Rt 3 Tylertown  
 (mailing address)

description of formations encountered	from	to
<u>Clay gravel</u>	<u>0</u>	<u>27</u>
<u>fine sand</u>	<u>27</u>	<u>65</u>
<u>Sand gravel</u>	<u>65</u>	<u>90</u>
<u>White Chalk</u>	<u>90</u>	<u>145</u>
<u>Coarse sand &amp; gravel</u>	<u>145</u>	<u>164</u>

**WELL LOCATION:**  
 sec. 11 T 3 N R. 9 E  
12 miles E-NE of McComb  
 (distance) (direction) (nearest town)

**WELL PURPOSE:** home  
 (home, irrigation, municipal, industrial)

**WELL COMPLETION DATA:**

(1) diameter (inches) 4"

(2) total depth (feet) 164'

(3) static water level (feet) 95' above top of ground.

(4) casing plastic, bottom  
 (material) (depth)

if telescope see back.  
 (size)

(5) screen 5' 159'  
 (length) (depth to top)

4" plastic  
 (size) (material)

(6) pump 3 12  
 (HP) (yield gpm)

split  
 (type power)

(7) electric log no  
 (yes or no)

(organization running log)

(8) how well bottom plugged  
wooden plug

**DRILLERS REMARKS:**  
old well hit by lightning


Misc. Board of Water Commis

FEB 15 1979

RECEIVED

If well telescopes please sketch and show depths.

GROUND LEVEL

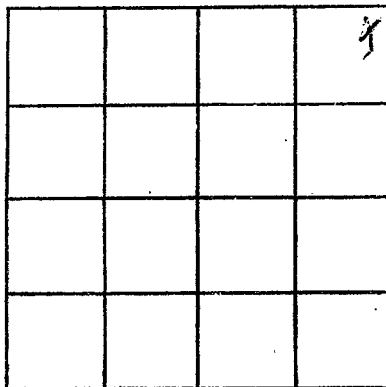

SECTION 11

Please indicate well location X.

ADDITIONAL INFORMATION

If more than one screen, show locations of each on sketch.