

Pike
E
2027
6-4-79

MISSISSIPPI
BOARD OF WATER COMMISSIONERS
416 North State Street
Jackson, Mississippi 39201

WATER WELL DRILLERS LOG

June 4 1979 Renew Well for Pipe
date well completed firm name county well located

LANDOWNER:
James (Red) Linton
Rt 1 McComb
(mailing address)

description of formations encountered	from	to
sand clay	0	12
white sand	12	30
broken sand & gravel	30	60
sand & gravel	60	62
sand & pea gravel	62	77

WELL LOCATION:
sec. 21 T 3 N R 9 E
9 miles east of McComb
(distance) (direction) (nearest town)

WELL PURPOSE: Camp
(home, irrigation, municipal, industrial)

- WELL COMPLETION DATA:
- (1) diameter (inches) 4"
 - (2) total depth (feet) 77
 - (3) static water level (feet) _____ below/above top of ground.
 - (4) casing plastic bottom
(material) (depth)
 - (size) if telescope see back.
 - (5) screen 5' 72"
(length) (depth to top)
 - 4" plastic
(size) (material)
 - (6) pump 1/2 HP 10
(HP) (yield gpm)
 - elect
(type power)
 - (7) electric log no
(yes or no)

(organization running log)

(8) how well bottom plugged
wooden plug

DRILLERS REMARKS:
L


DEPT. OF NATURAL RESOURCES
BUREAU OF LAND & WATER RESOURCES

NOV 19 1979

RECEIVED

If well telescopes please sketch and show depths.

GROUND LEVEL

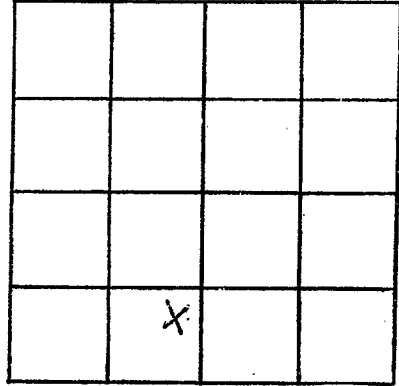

SECTION 21

Please indicate well location X.

ADDITIONAL INFORMATION

If more than one screen,
show locations of each on sketch.