

Pike
F
2028
10-18-79

MISSISSIPPI
BOARD OF WATER COMMISSIONERS
416 North State Street
Jackson, Mississippi 39201

WATER WELL DRILLERS LOG

10-18 19 79 ^{Fitzgould Well for} John Nettles Pike
date well completed firm name county well located

LANDOWNER:
John Nettles
P.O. Box 276, Corning, MS.
(mailing address)

description of formations encountered	from	to
Red clay	0	15
white clay	15	65
Coarse sand & gravel	65	80

WELL LOCATION:
sec. 15 T. 3 N. R. 9 E
S W
3 miles NW of Holmerville
(distance) (direction) (nearest town)

WELL PURPOSE: Home
(home, irrigation, municipal, industrial)

- WELL COMPLETION DATA:
- (1) diameter (inches) 4
 - (2) total depth (feet) 80
 - (3) static water level (feet) 25 below top of ground.
 - (4) casing PVC 72
(material) (depth)
4 if telescope see back.
(size)
 - (5) screen 8 72
(length) (depth to top)
4 PVC
(size) (material)
 - (6) pump 1/2 20
(HP) (yield gpm)
Electric
(type power)
 - (7) electric log no
(yes or no)
(organization running log)
 - (8) how well bottom plugged Sand block

DRILLERS REMARKS:


DEPT. OF NATURAL RESOURCES
BUREAU OF LAND & WATER RESOURCES

NOV - 7 1979

RECEIVED

If well telescopes please sketch and show depths.

GROUND LEVEL

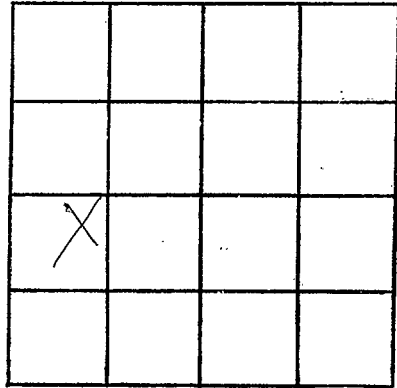

SECTION 15

Please indicate well location X.

ADDITIONAL INFORMATION

A series of horizontal lines for recording additional information.

If more than one screen, show locations of each on sketch.