

Pike
 F 2028
 6-16-79

MISSISSIPPI
 BOARD OF WATER COMMISSIONERS
 416 North State Street
 Jackson, Mississippi 39201

WATER WELL DRILLERS LOG

June 16 1979 *Newsall Sec* *Pike*
 date well completed firm name county well located

LANDOWNER:
J.D. Gill
Rt 1 Summit
 (mailing address)

description of formations encountered	from to	
<i>clay</i>	<i>0</i>	<i>22</i>
<i>red sand</i>	<i>22</i>	<i>80</i>
<i>sand & gravel</i>	<i>80</i>	<i>94</i>
<i>pebbles</i>	<i>94</i>	<i>110</i>
<i>sand & pea gravel</i>	<i>110</i>	<i>138</i>

WELL LOCATION:
 sec. *2* T *3* N R *9* E
4 miles *South* of *Preedale*
 (distance) (direction) (nearest town)

WELL PURPOSE: *Drain*
 (home, irrigation, municipal, industrial)

WELL COMPLETION DATA:
 (1) diameter (inches) *4"*
 (2) total depth (feet) *138*
 (3) static water level (feet) *77* below top of ground
 (4) casing *plastic bottom*
 (material) (depth)
 (size) if telescope see back.
 (5) screen *5'* *133'*
 (length) (depth to top)
4" *plastic*
 (size) (material)
 (6) pump *3/4* *12*
 (HP) (yield gpm)
electric
 (type power)
 (7) electric log *no*
 (yes or no)
 (organization running log)

(8) how well bottom plugged
wooden plug
 DRILLERS REMARKS:


DEPT. OF NATURAL RESOURCES
 BUREAU OF LAND & WATER RESOURCES

JAN 22 1990

RECEIVED

If well telescopes please sketch and show depths.

GROUND LEVEL

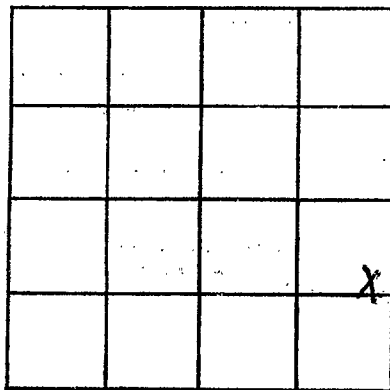

SECTION 2

Please indicate well location X.

ADDITIONAL INFORMATION

If more than one screen,
show locations of each on sketch.