

Pike
F 2031
12-31-79

MISSISSIPPI
 BOARD OF WATER COMMISSIONERS
 416 North State Street
 Jackson, Mississippi 39201

WATER WELL DRILLERS LOG

12-31 1979 F. J. ... Pike
 date well completed firm name county well located

LANDOWNER:
Jimmy Tucker
R.R. ...
 (mailing address)

description of formations encountered	from	to
<u>Red Clay</u>	<u>0</u>	<u>20</u>
<u>Gravel</u>	<u>20</u>	<u>26</u>
<u>Red Sand</u>	<u>26</u>	<u>90</u>
<u>Coarse sand & gravel</u>	<u>90</u>	<u>112</u>

WELL LOCATION:
 sec. 20 T. 3 (N) S R. 9 (E) W
9 miles E of McComb
 (distance) (direction) (nearest town)

WELL PURPOSE: Home
 (home, irrigation, municipal, industrial)

- WELL COMPLETION DATA:
- (1) diameter (inches) 4
 - (2) total depth (feet) 112
 - (3) static water level (feet) 15 below above top of ground.
 - (4) casing 4" PVC 104'
 (material) (depth)
4 if telescope see back.
 (size)
 - (5) screen 8" 164'
 (length) (depth to top)
4" PVC
 (size) (material)
 - (6) pump 1/2 HP 10
 (HP) (yield gpm)
ole
 (type power)
 - (7) electric log no
 (yes or no)
...
 (organization running log)
 - (8) how well bottom plugged Sand Plug

DRILLERS REMARKS:


DEPT. OF NATURAL RESOURCES
 BUREAU OF LAND & WATER RESOURCES

JAN 31 1980

RECEIVED

If well telescopes please sketch and show depths.

GROUND LEVEL

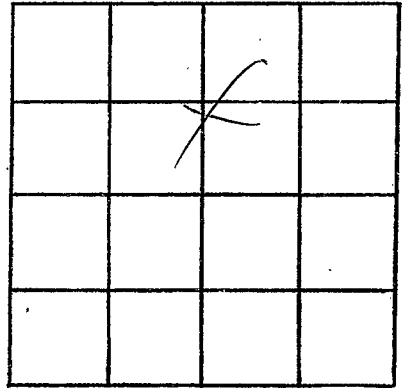

SECTION 20

Please indicate well location X.

ADDITIONAL INFORMATION

If more than one screen, show locations of each on sketch.