

PIKE
F 2022
4-30-80

MISSISSIPPI
BOARD OF WATER COMMISSIONERS
416 North State Street
Jackson, Mississippi 39201

WATER WELL DRILLERS LOG

4-30 date well completed 19 80 firm name H. J. ... county well located Pike

LANDOWNER:

Bill Stoble

B.R. McComb, ms.
(mailing address)

WELL LOCATION:

sec. 26 T. 3 N. R. 9 E
S W
2 miles E of Holmworth
(distance) (direction) (nearest town)

WELL PURPOSE: Home
(home, irrigation, municipal, industrial)

WELL COMPLETION DATA:

- (1) diameter (inches) 4
- (2) total depth (feet) 80
- (3) static water level (feet) 35 below above top of ground.
- (4) casing PVC, 72,
(material) (depth)
4 if telescope see back.
(size)
- (5) screen 8, 72
(length) (depth to top)
4, PVC
(size) (material)
- (6) pump 1/2, 10
(HP) (yield gpm)
Electric
(type power)
- (7) electric log No
(yes or no)
(organization running log)
- (8) how well bottom plugged Sealed

description of formations encountered

from to

<u>Red clay</u>	<u>0</u>	<u>20</u>
<u>Red gravel</u>	<u>20</u>	<u>40</u>
<u>white chalk</u>	<u>40</u>	<u>70</u>
<u>Coarse sand & gravel</u>	<u>70</u>	<u>80</u>

DRILLERS REMARKS:


DEPT. OF NATURAL RESOURCES
BUREAU OF LAND & WATER RESOURCES

JUN 20 1980

RECEIVED

If well telescopes please sketch and show depths.

GROUND LEVEL

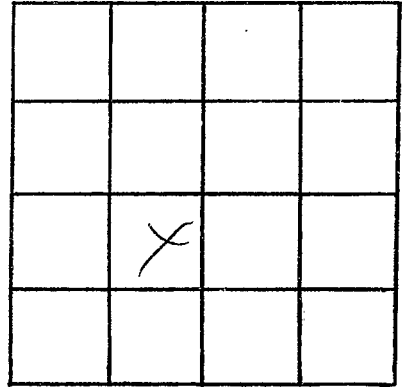

SECTION 26

Please indicate well location X.

ADDITIONAL INFORMATION

If more than one screen, show locations of each on sketch.