

Pike
F 2033
6-16-80
6-16 1980

MISSISSIPPI
 BOARD OF WATER COMMISSIONERS
 416 North State Street
 Jackson, Mississippi 39201

WATER WELL DRILLERS LOG

date well completed 1980 firm name F. Harold Well Serv county well located Pike

LANDOWNER:	description of formations encountered	from	to
<u>Jimmie Freeman</u>			
<u>P.B. McComb</u> (mailing address)	<u>Reddy</u>	<u>19</u>	<u>20</u>
WELL LOCATION:	<u>fine sand & gravel</u>	<u>20</u>	<u>88</u>
sec. <u>15</u> T <u>3</u> N R <u>9</u> E S W	<u>course sand & gravel</u>	<u>85</u>	<u>95</u>
<u>2</u> miles <u>NE</u> of <u>Holmville</u> (distance) (direction) (nearest town)			
WELL PURPOSE: <u>Home</u> (home, irrigation, municipal, industrial)			
WELL COMPLETION DATA:			
(1) diameter (inches) <u>4</u>			
(2) total depth (feet) <u>95</u>			
(3) static water level (feet) <u>31</u> below top of ground.			
(4) casing <u>PVC</u> , <u>87</u> (material) (depth)			
<u>4</u> (size) If telescope see back.			
(5) screen <u>8</u> , <u>87</u> (length) (depth to top)			
<u>4</u> , <u>PVC</u> (size) (material)			
(6) pump <u>1/2</u> <u>10</u> (HP) (yield gpm)			
<u>Electric</u> (type power)			
(7) electric log <u>NO</u> (yes or no)			
(organization running log)			
(8) how well bottom plugged <u>Seal Well</u>			
DRILLERS REMARKS:			


DEPT. OF NATURAL RESOURCES
 BUREAU OF LAND & WATER RESOURCES

JUN 20 1980

RECEIVED

If well telescopes please sketch and show depths.

GROUND LEVEL

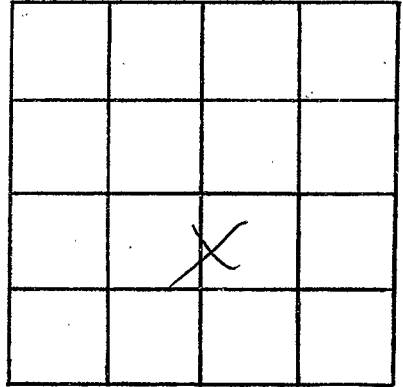

SECTION 15

Please indicate well location X.

ADDITIONAL INFORMATION

If more than one screen,
show locations of each on sketch.