

Pike
 F 2034
 7-4-80

MISSISSIPPI
 BOARD OF WATER COMMISSIONERS
 416 North State Street
 Jackson, Mississippi 39201

WATER WELL DRILLERS LOG

7-4 1980 date well completed
 Fitzgerald Well Serv firm name
 Pike county well located

LANDOWNER:
 H.R. Dyer
 R.B. McComb, Mrs.
 (mailing address)

description of formations encountered	from	to
Red clay	0	15
Red gravel	15	30
Thin sand	30	70
Coarse sand gravel	70	80

WELL LOCATION:
 sec. 27 T 30 N R 9 E
 S W
 2 miles E of Holmsville
 (distance) (direction) (nearest town)

WELL PURPOSE: Home
 (home, irrigation, municipal, industrial)

- WELL COMPLETION DATA:
- (1) diameter (inches) 4
 - (2) total depth (feet) 80
 - (3) static water level (feet) 30 below top of ground.
 - (4) casing PVC, 72 (material) (depth)
 4 (size) if telescope see back.
 - (5) screen 8, 72 (length) (depth to top)
 4 (size) PVC (material)
 - (6) pump 1/2 (HP) 10 (yield gpm)
 1/2 (type power)
 - (7) electric log yes (yes or no)
 - (organization running log)
 - (8) how well bottom plugged Sand blk


DRILLERS REMARKS:

DEPT. OF NATURAL RESOURCES
 BUREAU OF LAND & WATER RESOURCES

SEP 8 - 1980
 RECEIVED

If well telescopes please sketch and show depths.

GROUND LEVEL

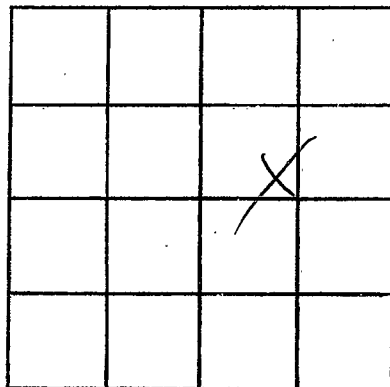

SECTION 27

Please indicate well location X.

ADDITIONAL INFORMATION

If more than one screen, show locations of each on sketch.