

MISSISSIPPI DEPARTMENT OF NATURAL RESOURCES

Bureau of Land and Water Resources

Southport Mall

P.O. Box 10631

Jackson, Mississippi 39209

WATER WELL DRILLERS LOG

PIKE  
F 2034  
4-4-80

April 4 1980 Reeves Miller Pike  
date well completed firm name county well located

LANDOWNER:  
Larry Campan

description of formations encountered	from	to
<u>Red Clay</u>	<u>0</u>	<u>12</u>
<u>Red sand</u>	<u>12</u>	<u>35</u>
<u>pink chalk</u>	<u>35</u>	<u>50</u>
<u>Red Sand &amp; pebbles</u>	<u>50</u>	<u>140</u>
<u>Coarse sand &amp; pebbles</u>	<u>140</u>	<u>157</u>

(mailing address)

WELL LOCATION:  
sec. 2 T. 3 N. R. 9 E  
3 miles South of pride Lake  
(distance) (direction) (nearest town)

WELL PURPOSE: Trailer  
(home, irrigation, municipal, industrial)

WELL COMPLETION DATA:

- (1) diameter (inches) 4"
- (2) total depth (feet) 157'
- (3) static water level (feet) 95' below top of ground.
- (4) casing Plastic Bottom  
(material) (depth)
- (size) If telescope see back.
- (5) screen 5' 157'  
(length) (depth to top)
- (size) 4" (material) plastic
- (6) pump 1/2 Sub 10  
(HP) (yield gpm)
- (type power) elect
- (7) electric log no  
(yes or no)
- (organization running log)

(8) how well bottom plugged  
back wash valve

DRILLERS REMARKS:


DEPT. OF NATURAL RESOURCES  
BUREAU OF LAND & WATER RESOURCES

JAN 12 1981

RECEIVED

If well telescopes please sketch and show depths.

GROUND LEVEL

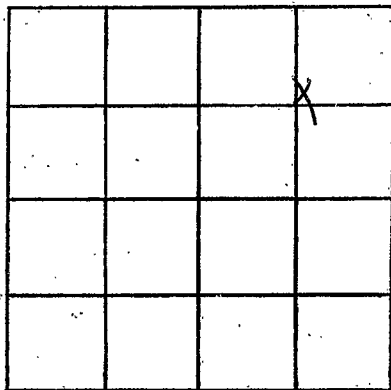

SECTION 2

Please indicate well location X.

ADDITIONAL INFORMATION

If more than one screen,  
show locations of each on sketch.