

Bureau of Land and Water Resources

Southport Mall

P.O. Box 10631

Jackson, Mississippi 39209

WATER WELL DRILLERS LOG

Pike  
F 2038  
10/20/80

Oct 20 1980 News Miller Pike  
date well completed firm name county well located

LANDOWNER:  
Glen Scoggon  
RT 2 MC Comb  
(mailing address)


description of formations encountered	from	to
Clay + Gravel	0	27
Yellow sand	27	85
Sand Rock	85	86
Blue Clay	86	150
fine sand	150	170
Coarse sand + peb Gravel	170	193

WELL LOCATION:  
sec 34 T 3 N R 9 E  
9 miles ESE of MC Comb  
(distance) (direction) (nearest town)

WELL PURPOSE: Trailer  
(home, irrigation, municipal, industrial)


- WELL COMPLETION DATA:
- (1) diameter (inches) 4"
  - (2) total depth (feet) 193'
  - (3) static water level (feet) 120' below top of ground.
  - (4) casing plastic bottom  
(material) (depth)
  - (size) If telescope see back.
  - (5) screen 5' 193'  
(length) (depth to top)
  - 4" plastic  
(size) (material)
  - (6) pump 3/4 Sub 12  
(HP) (yield gpm)
  - West  
(type power)
  - (7) electric log no  
(yes or no)
  - (organization running log)
  - (8) how well bottom plugged backwash

DRILLERS REMARKS:

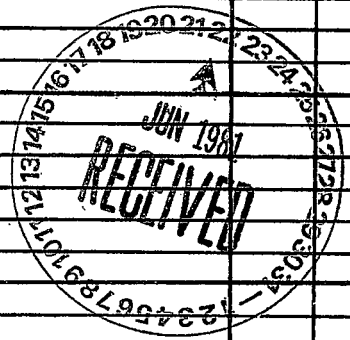

If well telescopes please sketch and show depths.

GROUND LEVEL

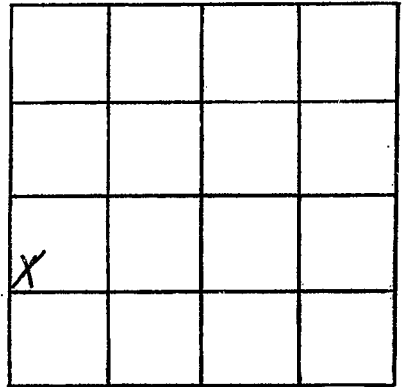

SECTION 34

Please indicate well location X.

ADDITIONAL INFORMATION

If more than one screen,  
show locations of each on sketch.