

MISSISSIPPI DEPARTMENT OF NATURAL RESOURCES

Bureau of Land and Water Resources

Southport Mall

P.O. Box 10631

Jackson, Mississippi 39209

WATER WELL DRILLERS LOG

PIKE
F 2039
11/8/80
Nov 8

19 80 Reeves Well Ser Pike

date well completed

firm name

county well located

LANDOWNER:

Carnot Matthews

Box 2 McComb
(mailing address)

description of formations encountered

from

to

clay 0 14
white sand 14 28
lobbly (pink) 28 36
fine gravel & sand 36 50

WELL LOCATION:

sec. 26 T 3 N R 9 E
2 1/2 miles east of Bonville
(distance) (direction) (nearest town)

WELL PURPOSE:

house
(home, irrigation, municipal, industrial)


WELL COMPLETION DATA:

- (1) diameter (inches) 4'
- (2) total depth (feet) 50
- (3) static water level (feet) 12 below above top of ground.
- (4) casing plastic bottom
(material) (depth)
- If telescope see back.
(size)
- (5) screen 5' 45'
(length) (depth to top)
- 4" plastic
(size) (material)
- (6) pump 1 hp 8
(HP) (yield gpm)
- elect
(type power)
- (7) electric log no
(yes or no)

(organization running log)


(8) how well bottom plugged
back wash

DRILLERS REMARKS:

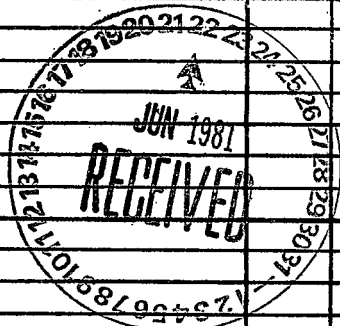

If well telescopes please sketch and show depths.

GROUND LEVEL

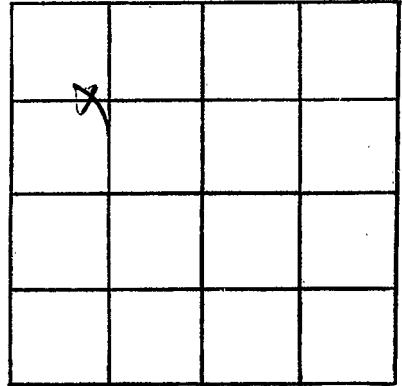

SECTION 26

Please indicate well location X.

ADDITIONAL INFORMATION

If more than one screen,
show locations of each on sketch.