

PIKE
F 2041
5-9-80

MISSISSIPPI
 BOARD OF WATER COMMISSIONERS
 416 North State Street
 Jackson, Mississippi 39201

WATER WELL DRILLERS LOG

date well completed May 9 1980 firm name Beems Well Ser county well located Pike

LANDOWNER:
Bob Wallace
Rt 1 Summit
 (mailing address)

WELL LOCATION:
 sec. 4 T 3 N R 9 E
3 miles south of prichard
 (distance) (direction) (nearest town)

WELL PURPOSE: home
 (home, irrigation, municipal, industrial)

WELL COMPLETION DATA:
 (1) diameter (inches) 4"
 (2) total depth (feet) 133'
 (3) static water level (feet) 90 below top of ground.
 (4) casing plastic bottom
 (material) (depth)
 (size) if telescope see back.
 (5) screen 5' 128'
 (length) (depth to top)
4" plastic
 (size) (material)
 (6) pump 1/2 sub 10
 (HP) (yield gpm)
elect
 (type power)
 (7) electric log no
 (yes or no)
 (organization running log)

(8) how well bottom plugged back wash valve

DRILLERS REMARKS:
✓

description of formations encountered	from	to
<u>red clay</u>	<u>0</u>	<u>17</u>
<u>sand & gravel</u>	<u>17</u>	<u>60</u>
<u>pink chert</u>	<u>60</u>	<u>70</u>
<u>gravel (hard)</u>	<u>70</u>	<u>82</u>
<u>shaly</u>	<u>82</u>	<u>110</u>
<u>coarse sand</u>	<u>110</u>	<u>133</u>


DEPT. OF NATURAL RESOURCES
 BUREAU OF LAND & WATER RESOURCES

FEB 2 - 1981

RECEIVED

If well telescopes please sketch and show depths.

GROUND LEVEL

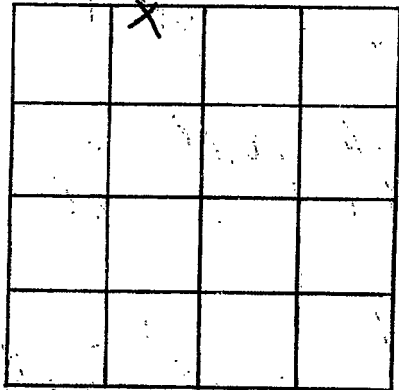

SECTION 4

Please indicate well location X.

ADDITIONAL INFORMATION

If more than one screen,
show locations of each on sketch.