

PEKE  
 F 2042  
 5-31-80  
 MAY 30 1980  
 date well completed

MISSISSIPPI  
 BOARD OF WATER COMMISSIONERS  
 416 North State Street  
 Jackson, Mississippi 39201

WATER WELL DRILLERS LOG

Reems wells Pipe  
 firm name county well located

LANDOWNER:  
 I. W. Barnes  
 Rt 2 McComb  
 (mailing address)

description of formations encountered	from	to
sandy clay	0	10
chalk	10	30
sand & gravel	30	40
lobbley & chalk	40	65
sand & fine gravel	65	73

WELL LOCATION:  
 sec. 21 T-3 N R-9 E  
 in miles of Holmsville  
 (distance) (direction) (nearest town)

WELL PURPOSE: home  
 (home, irrigation, municipal, industrial)

WELL COMPLETION DATA:

(1) diameter (inches) 4"

(2) total depth (feet) 73

(3) static water level (feet) 19' below above top of ground.

(4) casing plastic bottom  
 (material) (depth)

— if telescope see back.  
 (size)

(5) screen 5' 68'  
 (length) (depth to top)

4" plastic  
 (size) (material)

(6) pump 2 sub 10  
 (HP) (yield gpm)

cbt  
 (type power)

(7) electric log no  
 (yes or no)

—  
 (organization running log)

(8) how well bottom plugged  
 back wash valve

DRILLERS REMARKS:


DEPT. OF NATURAL RESOURCES  
 BUREAU OF LAND & WATER RESOURCES

FEB 2 1981

RECEIVED

If well telescopes please sketch and show depths.

GROUND LEVEL

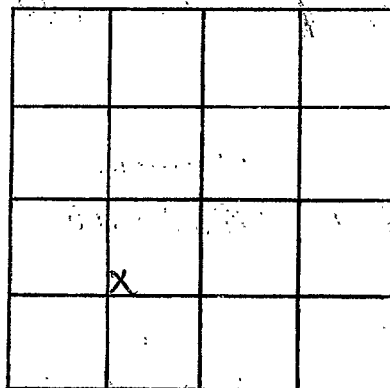

SECTION 21

Please indicate well location X.

ADDITIONAL INFORMATION

If more than one screen, show locations of each on sketch.