

PIPE  
 F 2043  
 7-23-80  
 July 23 1980

MISSISSIPPI  
 BOARD OF WATER COMMISSIONERS  
 416 North State Street  
 Jackson, Mississippi 39201

WATER WELL DRILLERS LOG

date well completed: July 23 1980  
 firm name: News Well Service  
 county well located: Pipe


LANDOWNER:  
 Floyd Looney  
 Rt 2 MC Comb  
 (mailing address)

description of formations encountered	from to	
	depth	depth
gravel & clay	0	35
red sand	35	70
clay, gravel & sand	70	163
pea gravel & sand	163	180

WELL LOCATION:  
 sec. 34 T. 3 N R. 9 E  
 10 1/2 miles east of MC Comb  
 (distance) (direction) (nearest town)

WELL PURPOSE: Trailer  
 (home, irrigation, municipal, industrial)


- WELL COMPLETION DATA:
- (1) diameter (inches) 4"
  - (2) total depth (feet) 178'
  - (3) static water level (feet) 120' below top of ground
  - (4) casing (material) plastic, (depth) bottom
  - (5) screen (size) 5', (length) 175', (depth to top)
  - (6) pump (size) 4", (material) plastic, (HP) 3, (yield gpm) 12
  - (7) electric log (type power) 4 HP (yes or no) no
  - (8) how well bottom plugged (organization running log) wood plugging

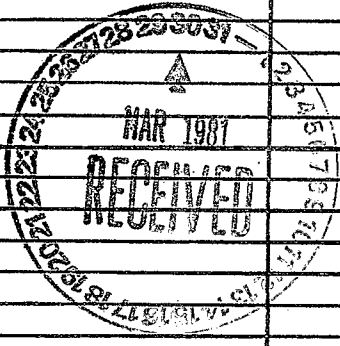

DRILLERS REMARKS:

If well telescopes please sketch and show depths.

GROUND LEVEL

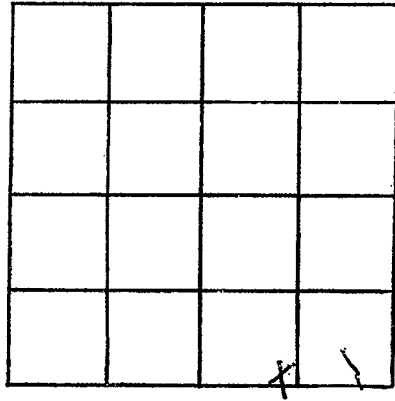

SECTION 34

Please indicate well location X.

ADDITIONAL INFORMATION

Lined area for additional information.

If more than one screen, show locations of each on sketch.