

Pike
 F 2044
 4-17-81

MISSISSIPPI
 BOARD OF WATER COMMISSIONERS
 416 North State Street
 Jackson, Mississippi 39201

WATER WELL DRILLERS LOG

4-17 1981 Stewart Well Serv Pike
 date well completed firm name county well located

LANDOWNER: Bessy Craft
R.R. McRoberts
 (mailing address)

description of formations encountered

	from	to
<u>Red Clay</u>	<u>0</u>	<u>70</u>
<u>Red Sand</u>	<u>10</u>	<u>60</u>
<u>Coarse Sand & Gravel</u>	<u>60</u>	<u>70</u>

WELL LOCATION:
 sec. 21 T. 3 N. R. 9 E
 S W

0.5 miles — of Holmesville
 (distance) (direction) (nearest town)

WELL PURPOSE: Home
 (home, irrigation, municipal, industrial)


- WELL COMPLETION DATA:
- (1) diameter (inches) 4
 - (2) total depth (feet) 75
 - (3) static water level (feet) 15 below above top of ground.
 - (4) casing 4 67
 (material) (depth)
4 If telescope see back.
 (size)
 - (5) screen 8 67
 (length) (depth to top)
4 PVC
 (size) (material)
 - (6) pump 1/2 10
 (HP) (yield gpm)
Electric
 (type power)
 - (7) electric log no
 (yes or no)
 (organization running log)
 - (8) how well bottom plugged Sealed

DRILLERS REMARKS:

MISSISSIPPI DEPARTMENT OF NATURAL RESOURCES
 BUREAU OF LAND & WATER RESOURCES
 APR 23 1981
 RECEIVED

If well telescopes please sketch and show depths.

GROUND LEVEL

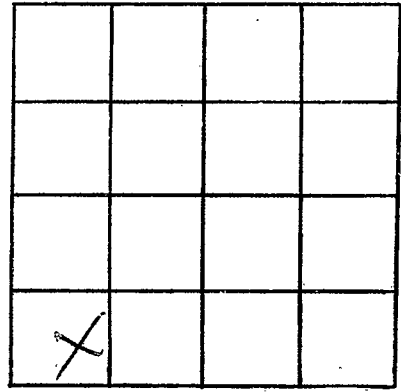

SECTION 21

Please indicate well location X.

ADDITIONAL INFORMATION

If more than one screen, show locations of each on sketch.