

Pike
 F 2045
 4-29-81

MISSISSIPPI
 BOARD OF WATER COMMISSIONERS
 416 North State Street
 Jackson, Mississippi 39201

WATER WELL DRILLERS LOG

4-29 1981 *Fitzgerald Well Serv* *Pike*
 date well completed firm name county well located


LANDOWNER: *Jimmy Tucker*
RR. McComb, ms.
 (mailing address)

description of formations encountered	from	to
<i>Red gravel</i>	<i>0</i>	<i>20</i>
<i>Coarse sand & gravel</i>	<i>10</i>	<i>50</i>

WELL LOCATION:
 sec *20* T *3* N R *9* E
 S W
8 miles *E* of *McComb*
 (distance) (direction) (nearest town)

WELL PURPOSE: *Home*
 (home, irrigation, municipal, industrial)


- WELL COMPLETION DATA:
- (1) diameter (inches) *4*
 - (2) total depth (feet) *50*
 - (3) static water level (feet) *25* below top of ground.
 - (4) casing *PVC*, *42*,
 (material) (depth)
4 if telescope see back.
 (size)
 - (5) screen *8*, *42*
 (length) (depth to top)
4, *PVC*
 (size) (material)
 - (6) pump *1/2*, *10*
 (HP) (yield gpm)
elec
 (type power)
 - (7) electric log *no*
 (yes or no)
 (organization running log)
 - (8) how well bottom plugged *Sand Shells*

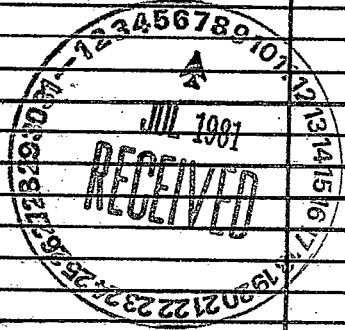

DRILLERS REMARKS:

If well telescopes please sketch and show depths.

GROUND LEVEL

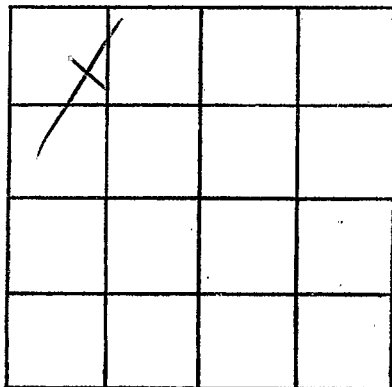

SECTION 20

Please indicate well location X.

ADDITIONAL INFORMATION

If more than one screen,
show locations of each on sketch.