

Pike  
 F 2046  
 9-9-81

MISSISSIPPI  
 BOARD OF WATER COMMISSIONERS  
 416 North State Street  
 Jackson, Mississippi 39201

WATER WELL DRILLERS LOG

9-9 date well completed 1981 Filbeck well Co firm name Pike county well located

LANDOWNER:	description of formations encountered	from	to
Jessie Walker RR. 3 Highway (mailing address)	Red clay Red sand white chalk coarse sand & gravel	0 20 40 140	20 40 140 152
<b>WELL LOCATION:</b> sec. 14 T-30 N R-9 E 6 miles SW of Egan (distance) (direction) (nearest town)			
<b>WELL PURPOSE:</b> Home (home, irrigation, municipal, industrial)			
<b>WELL COMPLETION DATA:</b>			
(1) diameter (inches) 4			
(2) total depth (feet) 152			
(3) static water level (feet) 60 below top of ground.			
(4) casing PVC, 144 (material) (depth)			
4 (size) if telescope see back.			
(5) screen 8, 144 (length) (depth to top)			
4 (size) PVC (material)			
(6) pump 1/2 (HP) 10 (yield gpm)			
electric (type power)			
(7) electric log yes (yes or no)			
(organization running log)			
(8) how well bottom plugged full			
<b>DRILLERS REMARKS:</b>			


DEPT. OF NATURAL RESOURCES  
 BUREAU OF LAND & WATER RESOURCES

SEP 30 1981

RECEIVED

If well telescopes please sketch and show depths.

GROUND LEVEL

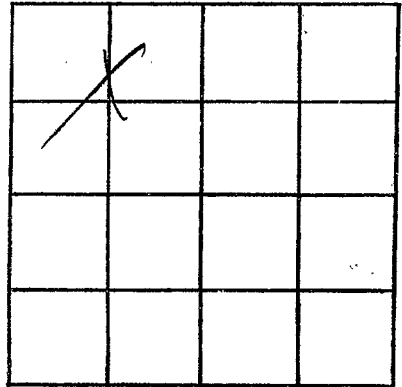

SECTION 14

Please indicate well location X.

ADDITIONAL INFORMATION

If more than one screen,  
show locations of each on sketch.