

Pike
F 2047

MISSISSIPPI DEPARTMENT OF NATURAL RESOURCES
 Bureau of Land and Water Resources
 Southport Mall
 P.O. Box 10631
 Jackson, Mississippi 39209
WATER WELL DRILLERS LOG

Aug 17 1981 Reems Well Dr Pike
 date well completed firm name county well located

LANDOWNER:
Loyde Jones Jr.
Rt 1 McComb
 (mailing address)

description of formations encountered	from	to
<u>Red Clay</u>	<u>0</u>	<u>25</u>
<u>sand & gravel</u>	<u>25</u>	<u>38</u>
<u>blue & white clay</u>	<u>35</u>	<u>109</u>
<u>fine sand</u>	<u>109</u>	<u>140</u>
<u>pea gravel & sand</u>	<u>140</u>	<u>157</u>

WELL LOCATION:
 sec 2 T 3 N R 9 E
3 miles Sandwich Rice Dale
 (distance) (direction) (nearest town)

WELL PURPOSE: home
 (home, irrigation, municipal, industrial)

- WELL COMPLETION DATA:
- (1) diameter (inches) 4"
 - (2) total depth (feet) 157
 - (3) static water level (feet) 70 below top of ground.
 - (4) casing plastic (material) bottom (depth)
 - " if telescope see back.
 - (5) screen 5' (length) 152' (depth to top)
 - 4" (size) plastic (material)
 - (6) pump 1/2 (HP) 10 (yield gpm)
 - split (type power)
 - (7) electric log no (yes or no)
 - (organization running log)


(8) how well bottom plugged:
back wash valve

DRILLERS REMARKS:

DEPT. OF NATURAL RESOURCES
 BUREAU OF LAND & WATER RESOURCES
 MAR 15 1982
RECEIVED

If well telescopes please sketch and show depths.

GROUND LEVEL

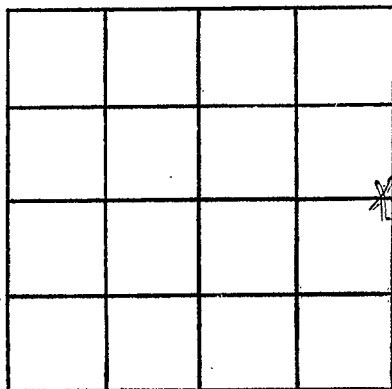

SECTION 3

Please indicate well location X.

ADDITIONAL INFORMATION

If more than one screen,
show locations of each on sketch.