

PIKE
 F.
 2068

MISSISSIPPI
 BOARD OF WATER COMMISSIONERS
 416 North State Street
 Jackson, Mississippi 39201

WATER WELL DRILLERS LOG

4-13 1982 Fitzgerald Well Serv Pike
 date well completed firm name county well located

LANDOWNER:	description of formations encountered	from	to
<u>Betty Joe Creel</u>	<u>Red Clay</u>	<u>0</u>	<u>20</u>
<u>R.R. McComb, Jr.</u> (mailing address)	<u>Red Sand</u>	<u>20</u>	<u>70</u>
<u>WELL LOCATION:</u> sec. <u>32</u> T <u>3</u> N R <u>9</u> E S W	<u>White Chalk</u>	<u>70</u>	<u>155</u>
<u>9</u> miles <u>E</u> of <u>McComb</u> (distance) (direction) (nearest town)	<u>Coarse sand & gravel</u>	<u>155</u>	<u>168</u>
<u>WELL PURPOSE:</u> <u>Home</u> (home, irrigation, municipal, industrial)			
<u>WELL COMPLETION DATA:</u>			
(1) diameter (inches) <u>4</u>			
(2) total depth (feet) <u>168</u>			
(3) static water level (feet) <u>75</u> below above top of ground.			
(4) casing <u>PVC</u> , <u>160</u> , (material) (depth)			
<u>4</u> if telescope see back. (size)			
(5) screen <u>8</u> , <u>160</u> (length) (depth to top)			
<u>4</u> , <u>PVC</u> (size) (material)			
(6) pump <u>1/2</u> , <u>10</u> (HP) (yield gpm)			
<u>Electric</u> (type power)			
(7) electric log <u>No</u> (yes or no)			
<u>(organization running log)</u>			
(8) how well bottom plugged <u>Sand sh</u>			
<u>DRILLERS REMARKS:</u>			


DEPT. OF NATURAL RESOURCES
 BUREAU OF LAND & WATER RESOURCES

MAY 25 1982

RECEIVED

If well telescopes please sketch and show depths.

GROUND LEVEL

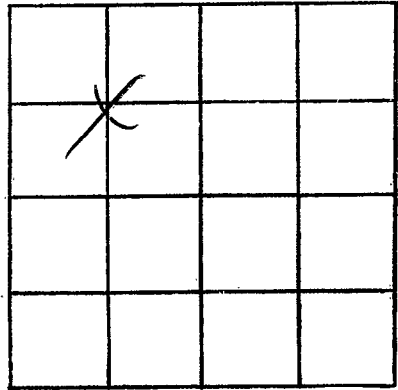

SECTION 32

Please indicate well location X.

ADDITIONAL INFORMATION

If more than one screen,
show locations of each on sketch.