

PIKE
F 2050

MISSISSIPPI
BOARD OF WATER COMMISSIONERS
416 North State Street
Jackson, Mississippi 39201

WATER WELL DRILLERS LOG

4-15 date well completed 82 Fitzgerald well no firm name Pike county well located

LANDOWNER: Bob Calotta
R.R. McComb Ms.
(mailing address)
WELL LOCATION: sec. 33 T 3 N R 9 E S W
9 miles E of McComb
(distance) (direction) (nearest town)

WELL PURPOSE: Home
(home, irrigation, municipal, industrial)

- WELL COMPLETION DATA:
- (1) diameter (inches) 4
 - (2) total depth (feet) 178
 - (3) static water level (feet) 110 below top of ground.
 - (4) casing PVC, 100 (material) (depth) 4 (size) if telescope see back.
 - (5) screen 8 (length) 170 (depth to top) 4 (size) PVC (material)
 - (6) pump 1/2 (HP) 10 (yield gpm) Elec (type power)
 - (7) electric log No (yes or no)
(organization running log)
 - (8) how well bottom plugged Sand Shok


description of formations encountered	from	to
Red Clay	0	20
Red sand	20	80
White & Blue chalk	50	165
Coarse sand & gravel	165	178

DEPT. OF NATURAL RESOURCES
BUREAU OF LAND & WATER RESOURCES
MAY 25 1982
RECEIVED

DRILLERS REMARKS:

If well telescopes please sketch and show depths.

GROUND LEVEL

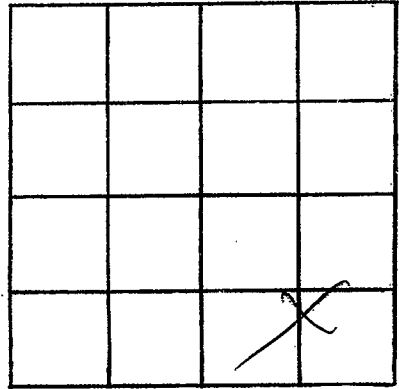

SECTION 33

Please indicate well location X.

ADDITIONAL INFORMATION

If more than one screen, show locations of each on sketch.