

MISSISSIPPI DEPARTMENT OF NATURAL RESOURCES

Bureau of Land and Water Resources

Southport Mall

P.O. Box 10631

Jackson, Mississippi 39209

WATER WELL DRILLERS LOG

PIKE
F
2052

May 11 1982 Rever Well in Pike
 date well completed firm name county well located

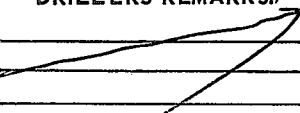
LANDOWNER:
Mr. Floyd Loney
RT 2 MC Comb
 (mailing address)

description of formations encountered	from	to
gravel + clay	0	25
sand + silt + gravel	25	60
white chert	60	90
fine white sand	90	150
sand + pebbles	150	186

WELL LOCATION:
 sec 34 T 2 N R 9 E
10 1/2 miles east of MC Comb
 (distance) (direction) (nearest town)

WELL PURPOSE: Trailer
 (home, irrigation, municipal, industrial)

- WELL COMPLETION DATA:
- (1) diameter (inches) 4"
 - (2) total depth (feet) 180
 - (3) static water level (feet) 110 below above top of ground.
 - (4) casing plastic bottom
 (material) (depth)
 (size) if telescope see back.
 - (5) screen 5" 175'
 (length) (depth to top)
4" plastic
 (size) (material)
 - (6) pump used old pump
 (HP) (yield gpm)
split
 (type power)
 - (7) electric log no
 (yes or no)
 (organization running log)
 - (8) how well bottom plugged/
back wash

DRILLERS REMARKS:


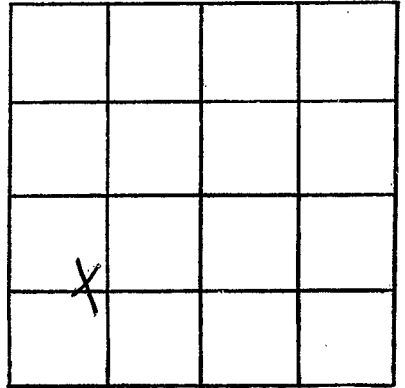
DEPT. OF NATURAL RESOURCES
 BUREAU OF LAND & WATER RESOURCES

NOV 16 1982

RECEIVED

If well telescopes please sketch and show depths.

GROUND LEVEL



SECTION 34

Please indicate well location X.

ADDITIONAL INFORMATION

If more than one screen,
show locations of each on sketch.