

MISSISSIPPI DEPARTMENT OF NATURAL RESOURCES

Bureau of Land and Water Resources

Southport Mall

P.O. Box 10631

Jackson, Mississippi 39209

WATER WELL DRILLERS LOG

PIKE
F
2053

May 4 1982 Russ Miller Pipe  
 date well completed firm name county well located

LANDOWNER:  
Lynn Pittman  
Rt. Summit  
 (mailing address)

description of formations encountered	from	to
red clay	0	16
Red Chalk & gravel	16	50
Gravel & sand	50	90
sea gravel & sand	90	146

WELL LOCATION:  
 sec. 5 T 3 N R. 9 E  
4 1/2 miles S-SW of Princeton  
 (distance) (direction) (nearest town)

WELL PURPOSE: home  
 (home, irrigation, municipal, industrial)

WELL COMPLETION DATA:

(1) diameter (inches) 4"

(2) total depth (feet) 146

(3) static water level (feet) 110 below above top of ground.

(4) casing plastic bottom  
 (material) (depth)

— if telescope see back.  
 (size)

(5) screen 5 141  
 (length) (depth to top)

4" plastic  
 (size) (material)

(6) pump by others  
 (HP) (yield gpm)

elect  
 (type power)

(7) electric log no  
 (yes or no)

—  
 (organization running log)

(8) how well bottom plugged back west valve

DRILLERS REMARKS:  
—


DEPT. OF NATURAL RESOURCES  
 BUREAU OF LAND & WATER RESOURCES

NOV 16 1982

RECEIVED

If well telescopes please sketch and show depths.

GROUND LEVEL

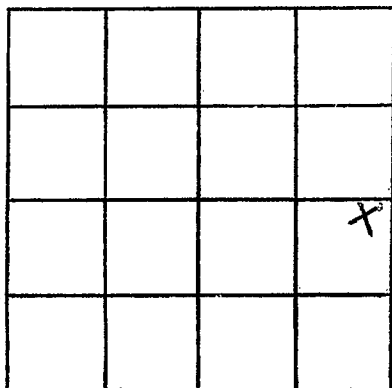

SECTION 5

Please indicate well location X.

ADDITIONAL INFORMATION

If more than one screen, show locations of each on sketch.