

MISSISSIPPI DEPARTMENT OF NATURAL RESOURCES

Bureau of Land and Water Resources

Southport Mall

P.O. Box 10631

Jackson, Mississippi 39209

WATER WELL DRILLERS LOG

PIKE  
F  
2054

June 17 1982 Prime Well Pike  
date well completed firm name county well located

LANDOWNER:  
Bobby Ray Williams  
Rt 1 McComb  
(mailing address)

description of formations encountered	from	to
<u>Red Clay</u>	<u>0</u>	<u>25</u>
<u>brown sand</u>	<u>25</u>	<u>55</u>
<u>Gravel &amp; sand</u>	<u>55</u>	<u>105</u>
<u>Coarse sand</u>	<u>105</u>	<u>165</u>
<u>+ pea gravel</u>		

WELL LOCATION:  
sec. 12 T. 3 N. R. 9 E  
6 miles east of McCombs  
(distance) (direction) (nearest town)

WELL PURPOSE: Truck  
(home, irrigation, municipal, industrial)

WELL COMPLETION DATA:

(1) diameter (inches) 4"

(2) total depth (feet) 165'

(3) static water level (feet) 110 below above top of ground.

(4) casing plastic bottom  
(material) (depth)

2 if telescope see back.  
(size)

(5) screen 5' 160'  
(length) (depth to top)

4" plastic  
(size) (material)

(6) pump 3 sub 12  
4 (HP) (yield gpm)

elect  
(type power)

(7) electric log no  
(yes or no)

—  
(organization running log)

(8) how well bottom plugged  
back wash

DRILLERS REMARKS:  
—


DEPT. OF NATURAL RESOURCES  
BUREAU OF LAND & WATER RESOURCES

NOV 22 1982

RECEIVED

If well telescopes please sketch and show depths.

GROUND LEVEL

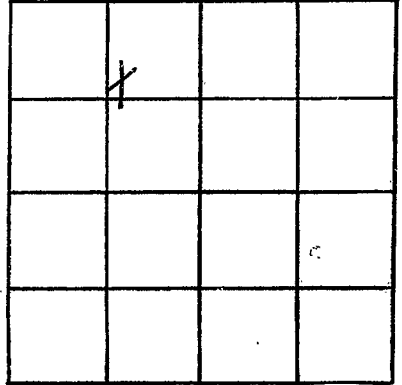

SECTION 12

Please indicate well location X.

ADDITIONAL INFORMATION

If more than one screen, show locations of each on sketch.