

PIKE
F
2055

MISSISSIPPI DEPARTMENT OF NATURAL RESOURCES

Bureau of Land and Water Resources

Southport Mall

P.O. Box 10631

Jackson, Mississippi 39209

WATER WELL DRILLERS LOG

Oct 4 19**82**
date well completed

firm name

county well located

Newn Miller Pike

LANDOWNER:

Orvil Limmonis

At 2 M.C. Conner

(mailing address)

WELL LOCATION:

sec **28** T **3** N R **9** E
1 miles **5** of **Homesville**
(distance) (direction) (nearest town)

WELL PURPOSE:

(home, irrigation, municipal, industrial)

WELL COMPLETION DATA:

- (1) diameter (inches) **4"**
(2) total depth (feet) **200'**
(3) static water level (feet) **125'** below top of ground.
(4) casing **plastic bottom**
(material) (depth)

(size) if telescope see back.

- (5) screen **10'** , **190'**
(length) (depth to top)

4" , **plastic**
(size) (material)

- (6) pump **3 hp** **12**
(HP) (yield gpm)

split
(type power)

- (7) electric log **no**
(yes or no)

(organization running log)

- (8) how well bottom plugged/
back wash

DRILLERS REMARKS:

old well
sanded up

description of formations encountered

from

to

| | | |
|-------------------|-----|-----|
| Red Clay | 0 | 20 |
| sand & red gravel | 20 | 80 |
| Red Chalk | 50 | 62 |
| sand & gravel | 62 | 75 |
| Red Chalk | 75 | 95 |
| lime Chalk & sand | 95 | 160 |
| sand & red gravel | 160 | 200 |


DEPT. OF NATURAL RESOURCES
BUREAU OF LAND & WATER RESOURCES

FEB 24 1983

RECEIVED

If well telescopes please
sketch and show depths.

GROUND LEVEL

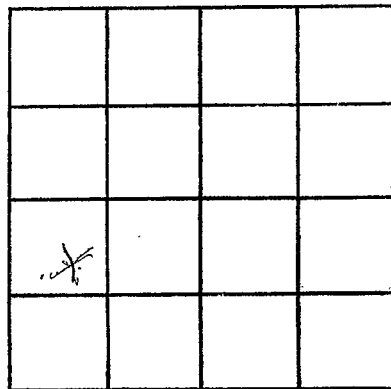

SECTION 28

Please indicate well location X.

ADDITIONAL INFORMATION

If more than one screen,
show locations of each on sketch.