

MISSISSIPPI DEPARTMENT OF NATURAL RESOURCES

Bureau of Land and Water Resources

Southport Mall

P.O. Box 10631

Jackson, Mississippi 39209

WATER WELL DRILLERS LOG

PIKE
F
2058

date well completed 2-7 1983 firm name Federal Well Service county well located Pike

LANDOWNER:	description of formations encountered	from	to
<u>Ed McCalish</u>			
<u>R.R. McComb</u> (mailing address)	<u>Red Sand</u>	<u>20</u>	<u>75</u>
WELL LOCATION:	<u>White & blue chert</u>	<u>75</u>	<u>210</u>
sec. <u>30</u> T. <u>3</u> N R. <u>9</u> E	<u>Green sand & gravel</u>	<u>210</u>	<u>225</u>
S W			
<u>8</u> miles <u>E</u> of <u>McComb</u>			
(distance) (direction) (nearest town)			
WELL PURPOSE: (home, irrigation, municipal, industrial)			
WELL COMPLETION DATA:			
(1) diameter (inches) <u>4</u>			
(2) total depth (feet) <u>225</u>			
(3) static water level (feet) <u>110</u> below above top of ground.			
(4) casing <u>4</u> (material) <u>117</u> (depth)			
<u>4</u> (size) if telescope see back.			
(5) screen <u>8</u> (length) <u>117</u> (depth to top)			
<u>4</u> (size) <u>4</u> (material)			
(6) pump <u>1/2</u> (HP) <u>10</u> (yield gpm)			
<u>Elc</u> (type power)			
(7) electric log <u>no</u> (yes or no)			
(organization running log)			
(8) how well bottom plugged <u>well</u>			

DEPT. OF NATURAL RESOURCES
BUREAU OF LAND & WATER RESOURCES


MAY 9 - 1983

RECEIVED

DRILLERS REMARKS:

If well telescopes please sketch and show depths.

GROUND LEVEL

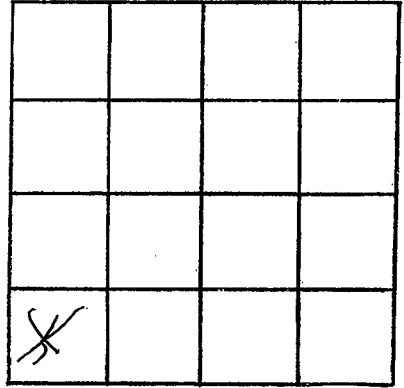

SECTION 30

Please indicate well location X.

ADDITIONAL INFORMATION

If more than one screen,
show locations of each on sketch.