

MISSISSIPPI DEPARTMENT OF NATURAL RESOURCES

Bureau of Land and Water Resources

Southport Mall

P.O. Box 10631

Jackson, Mississippi 39209

WATER WELL DRILLERS LOG

Pike

F

2059

5-31
date well completed

19 *83* *Fitzgerald*
firm name

Pike
county well located

LANDOWNER:

Edelia C. Kitehurst

P.O. Jayessons.
(mailing address)

description of formations encountered

from

to

<i>Red clay</i>	<i>0</i>	<i>20</i>
<i>Red sand</i>	<i>20</i>	<i>90</i>
<i>Coarse sandstone</i>	<i>90</i>	<i>150</i>

WELL LOCATION:

sec. *2* T *3* N R *9* E
S W
3 miles *S* of *Pinola*
(distance) (direction) (nearest town)

WELL PURPOSE:

Home
(home, irrigation, municipal, industrial)

WELL COMPLETION DATA:

- (1) diameter (inches) *4*
- (2) total depth (feet) *150*
- (3) static water level (feet) *120* below above-top of ground.
- (4) casing *PVC 142*,
(material) (depth)
4 if telescope see back.
(size)
- (5) screen *8*, *142*
(length) (depth to top)
4, *PVC*
(size) (material)
- (6) pump *1/2*, *10*
(HP) (yield gpm)
elec
(type power)
- (7) electric log *no*
(yes or no)

(organization running log)

(8) how well bottom plugged *sealed*

DEPT. OF NATURAL RESOURCES
BUREAU OF LAND & WATER RESOURCES


JUL 11 1983

RECEIVED

DRILLERS REMARKS:

If well telescopes please sketch and show depths.

GROUND LEVEL

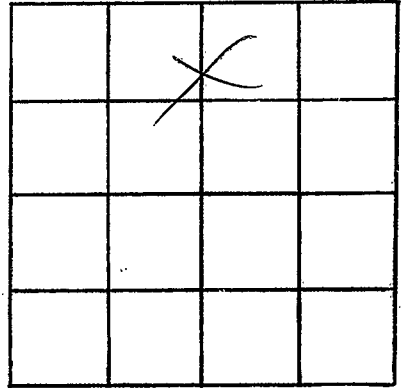

SECTION 2

Please indicate well location X.

ADDITIONAL INFORMATION

If more than one screen, show locations of each on sketch.