

MISSISSIPPI DEPARTMENT OF NATURAL RESOURCES

Bureau of Land and Water Resources

Southport Mall

P.O. Box 10631

Jackson, Mississippi 39209

WATER WELL DRILLERS LOG

PIKE
F 20060

July 23 1983 Mississippi Pike
 date well completed firm name county well located

LANDOWNER:
Bill Stroble
 Rt 2 McComb
 (mailing address)

description of formations encountered	from	to
<u>Sand</u>	<u>0</u>	<u>18</u>
<u>Clay</u>	<u>18</u>	<u>40</u>
<u>fine sand</u>	<u>40</u>	<u>70</u>
<u>Coarse sand</u>	<u>70</u>	<u>77</u>

WELL LOCATION:
 sec. 27 T. 3 N R. 9 E
2 miles East of Hoswell
 (distance) (direction) (nearest town)

WELL PURPOSE: Camp
 (home, irrigation, municipal, industrial)

- WELL COMPLETION DATA:
- (1) diameter (inches) 4"
 - (2) total depth (feet) 77
 - (3) static water level (feet) 11 ^{below} top of ground.
 - (4) casing plastic button
 (material) (depth)
 - _____ if telescope see back.
 (size)
 - (5) screen 5' 72'
 (length) (depth to top)
 - 4" plastic
 (size) (material)
 - (6) pump Sub 8
 (HP) (yield gpm)
 - skid
 (type power)
 - (7) electric log no
 (yes or no)
 - _____ (organization running log)

(8) how well bottom plugged lock wash

DRILLERS REMARKS:


DEPT. OF NATURAL RESOURCES
 BUREAU OF LAND & WATER RESOURCES

NOV - 3 1983

RECEIVED

If well telescopes please sketch and show depths.

GROUND LEVEL

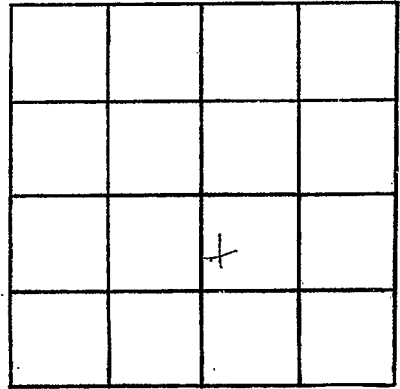

SECTION 27

Please indicate well location X.

ADDITIONAL INFORMATION

If more than one screen, show locations of each on sketch.