

MISSISSIPPI DEPARTMENT OF NATURAL RESOURCES

Bureau of Land and Water Resources

Southport Mall

P.O. Box 10631

Jackson, Mississippi 39209

WATER WELL DRILLERS LOG

PIKE
F2062

6-26
date well completed

19 84

Howard Lee
firm name

Pike
county well located

LANDOWNER:
Percy & Linda Chester

(mailing address)

description of formations encountered	from	to
Clay	1	70
Sand & Gravel	70	120
Clay	120	145
Sand	145	174

WELL LOCATION:
sec. 30 3 N R 9 E
S W
6 miles SE of McComb
(distance) (direction) (nearest town)

WELL PURPOSE: home
(home, irrigation, municipal, industrial)

- WELL COMPLETION DATA:
- (1) diameter (inches) 4
 - (2) total depth (feet) 174
 - (3) static water level (feet) 120 below above top of ground.
 - (4) casing PVC 164
(material) (depth)
4"
(size) if telescope see back.
 - (5) screen 10' 164'
(length) (depth to top)
.010 PVC
(size) (material)
 - (6) pump _____ (HP) _____ (yield gpm)
(type power)
 - (7) electric log no
(yes or no)
(organization running log)
 - (8) how well bottom plugged
back wash valve

DRILLERS REMARKS:


DEPT. OF NATURAL RESOURCES
BUREAU OF LAND & WATER RESOURCES

AUG 23 1964

RECEIVED

If well telescopes please sketch and show depths.

GROUND LEVEL

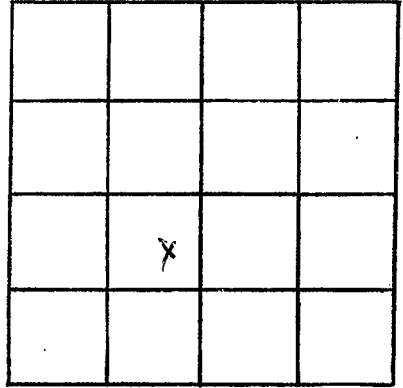

SECTION 30

Please indicate well location X.

ADDITIONAL INFORMATION

If more than one screen,
show locations of each on sketch.