

MISSISSIPPI DEPARTMENT OF NATURAL RESOURCES

Bureau of Land and Water Resources

Southport Mall

P.O. Box 10631

Jackson, Mississippi 39209

WATER WELL DRILLERS LOG

PIKE
F 20063

10-1 1984 Flanagan Well Service Pike  
 date well completed firm name county well located

LANDOWNER:	description of formations encountered	from	to
<u>Hezzie Quinn</u>			
<u>P.R. 3 Tylertown ms.</u> (mailing address)	<u>Red sand</u>	<u>20</u>	<u>100</u>
WELL LOCATION:	<u>White chalk</u>	<u>100</u>	<u>150</u>
sec. <u>11</u> T. <u>3</u> N R. <u>9</u> E S W	<u>Course sand &amp; gravel</u>	<u>150</u>	<u>160</u>
<u>5</u> miles <u>SE</u> of <u>Pineblake</u> (distance) (direction) (nearest town)			
WELL PURPOSE: <u>Home</u> (home, irrigation, municipal, industrial)			
WELL COMPLETION DATA:			
(1) diameter (inches) <u>4</u>			
(2) total depth (feet) <u>160</u>			
(3) static water level (feet) <u>110</u> below top of ground.			
(4) casing <u>PVC</u> , <u>152</u> , (material) (depth)			
<u>4</u> (size) if telescope see back.			
(5) screen <u>8</u> , <u>152</u> (length) (depth to top)			
<u>4</u> , <u>PVC</u> (size) (material)			
(6) pump <u>1/2</u> , <u>10</u> (HP) (yield gpm)			
<u>Electric</u> (type power)			
(7) electric log <u>no</u> (yes or no)			
(organization running log)			
(8) how well bottom plugged <u>Sand stop</u>			
DRILLERS REMARKS:			

DEPT. OF NATURAL RESOURCES  
 BUREAU OF LAND & WATER RESOURCES


DEC - 4 1984

RECEIVED

MISSISSIPPI DEPARTMENT OF NATURAL RESOURCES

If well telescopes please sketch and show depths.

GROUND LEVEL

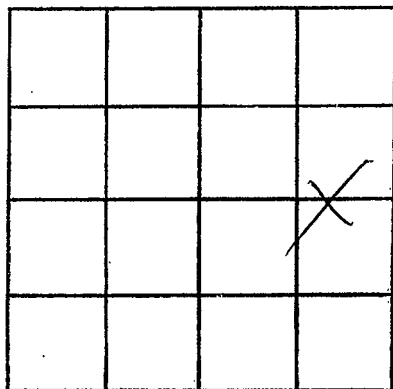

SECTION 11

Please indicate well location X.

ADDITIONAL INFORMATION

If more than one screen,  
show locations of each on sketch.