

MISSISSIPPI DEPARTMENT OF NATURAL RESOURCES

Bureau of Land and Water Resources

Southport Mall

P.O. Box 10631

Jackson, Mississippi 39209

WATER WELL DRILLERS LOG

*Pike*  
*P 2006*

6-26

19

84

*[Signature]*

Pike

date well completed

firm name

county well located


LANDOWNER:  
**Percy & Linda Chester**  
  
(mailing address)

description of formations encountered	from	to
Clay	1	70
Sand & Gravel	70	120
Clay	170	145
Sand	145	174

WELL LOCATION:  
sec. 30 T. 3 N. R. 2 E.  
S. W.  
4 miles SE of McComb  
(distance) (direction) (nearest town)

WELL PURPOSE: HOME  
(home, irrigation, municipal, industrial)

- WELL COMPLETION DATA:
- (1) diameter (inches) 4
  - (2) total depth (feet) 174
  - (3) static water level (feet) 120 below above top of ground.
  - (4) casing PVC 164  
(material) (depth)  
4"  
(size) if telescope see back.
  - (5) screen 10" 164"  
(length) (depth to top)  
#010 PVC  
(size) (material)
  - (6) pump \_\_\_\_\_ (HP) \_\_\_\_\_ (yield gpm)  
(type power)
  - (7) electric log no  
(yes or no)  
(organization running log)
  - (8) how well bottom plugged  
back wash valve

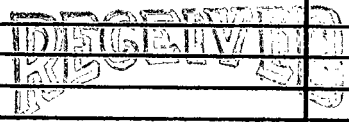

JUL 25 1984

DRILLERS REMARKS:

If well telescopes please sketch and show depths.

GROUND LEVEL

	X		

SECTION 30

Please indicate well location X.

ADDITIONAL INFORMATION

If more than one screen,  
show locations of each on sketch.