

MISSISSIPPI DEPARTMENT OF NATURAL RESOURCES
Bureau of Land and Water Resources
 Southport Mall
 P.O. Box 10631
 Jackson, Mississippi 39209
WATER WELL DRILLERS LOG

Pike

F


2065

12-6 19*84* *Fitzgerald well log* *Pike*
 date well completed firm name county well located

LANDOWNER:	description of formations encountered	from	to
<i>Memie Bullback</i>			
<i>R.R. 2, Mt. Vernon</i> (mailing address)	<i>Red clay</i> <i>Red sand</i> <i>Coarse sand & gravel</i>	<i>0</i> <i>20</i> <i>80</i>	<i>20</i> <i>80</i> <i>115</i>
WELL LOCATION:			
sec. <i>32</i> T- <i>3</i> N R- <i>9</i> E S W <i>8</i> miles <i>E</i> of <i>Mt. Vernon</i> (distance) (direction) (nearest town)			
WELL PURPOSE: (home, irrigation, municipal, industrial) <i>Home</i>			
WELL COMPLETION DATA:			
(1) diameter (inches) <i>4</i>			
(2) total depth (feet) <i>115</i>			
(3) static water level (feet) <i>55</i> below above top of ground.			
(4) casing <i>PVC 107</i> , (material) (depth) <i>4</i> (size) if telescope see back.			
(5) screen <i>8</i> , <i>107</i> (length) (depth to top) <i>4</i> , <i>PVC</i> (size) (material)			
(6) pump <i>1/2</i> , <i>10</i> (HP) (yield gpm) <i>Electric</i> (type power)			
(7) electric log <i>no</i> (yes or no)			
(8) how well bottom plugged <i>Salts</i>			
(organization running log) <i>Rec'd 1-7-85</i> <i>240</i>			
DRILLERS REMARKS:			

If well telescopes please sketch and show depths.

GROUND LEVEL

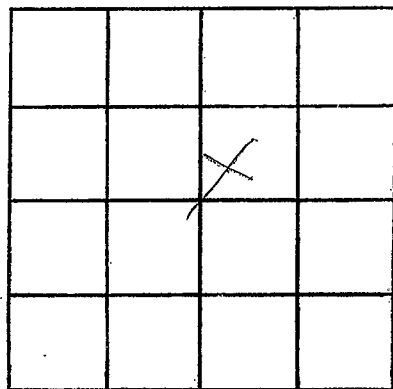

SECTION 32

Please indicate well location X.

ADDITIONAL INFORMATION

If more than one screen,
show locations of each on sketch.