

MISSISSIPPI DEPARTMENT OF NATURAL RESOURCES

Bureau of Land and Water Resources

Southport Mall

P.O. Box 10631

Jackson, Mississippi 39209

WATER WELL DRILLERS LOG

Pike
F 2006
6-5-85

L

6-5-1985 date well completed
F. General Hotel firm name
Pike county well located

LANDOWNER:	description of formations encountered	from	to
Bill Catten			
P.R. 2, McComb, ms. (mailing address)	Red clay Red sand Coarse sand & gravel	0 20 105	20 105 119
WELL LOCATION:			
sec. 15 T. 3 N R. 9 E S W 2 miles NE of Hattiesville (distance) (direction) (nearest town)			
WELL PURPOSE: Home (home, irrigation, municipal, industrial)			
WELL COMPLETION DATA:			
(1) diameter (inches) 4			
(2) total depth (feet) 119			
(3) static water level (feet) 50 below top of ground.			
(4) casing PVC, 109 (depth) 4 (size) if telescope see back.			
(5) screen 10 (length), 109 (depth to top)			
(6) pump 1/2 (HP), PVC (material), 10 (yield gpm)			
(7) electric log (yes or no) No			
(8) how well bottom plugged Sand Shale			


RECEIVED
JUL 22 1985

Department of Natural Resources
Bureau of Land & Water Resources

DRILLERS REMARKS:

If well telescopes please sketch and show depths.

GROUND LEVEL

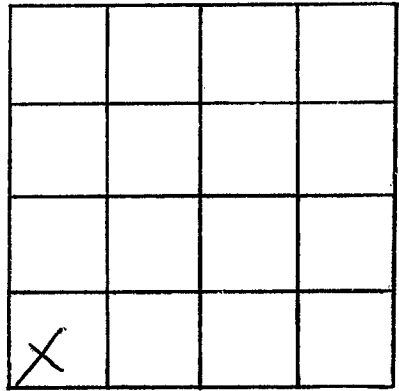

SECTION 15

Please indicate well location X.

ADDITIONAL INFORMATION

If more than one screen,
show locations of each on sketch.