

MISSISSIPPI DEPARTMENT OF NATURAL RESOURCES

Bureau of Land and Water Resources

Southport Mall

P.O. Box 10631

Jackson, Mississippi 39209

WATER WELL DRILLERS LOG

Fader  
PIKE  
8-22-85

8-22

1985

Fitzgerald Well Serv


Pike

date well completed

firm name

county well located


LANDOWNER:	description of formations encountered	from	to
<u>Randy Simmons</u> <u>P.O. 2 McComb</u> (mailing address)			
WELL LOCATION: sec. <u>30</u> T. <u>3</u> N R. <u>9</u> E S W			
<u>7</u> miles <u>E</u> of <u>McComb</u> (distance) (direction) (nearest town)			
WELL PURPOSE: <u>Home</u> (home, irrigation, municipal, industrial)			
WELL COMPLETION DATA: (1) diameter (inches) <u>4</u> (2) total depth (feet) <u>170</u> (3) static water level (feet) <u>130</u> below above top of ground. (4) casing <u>PVC</u> <u>160</u> (material) (depth) <u>4</u> (size) If telescope see back. (5) screen <u>10</u> <u>160</u> (length) (depth to top) <u>4</u> <u>PVC</u> (size) (material) (6) pump <u>3/4</u> <u>15</u> (HP) (yield gpm) <u>etc</u> (type power) (7) electric log <u>no</u> (yes or no) (organization running log) (8) how well bottom plugged <u>Sand filter</u>			
OTHER REMARKS:			

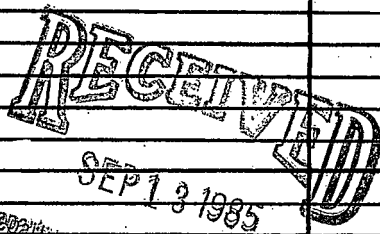

Department of Natural Resources  
 Bureau of Land & Water Resources

If well telescopes please sketch and show depths.

GROUND LEVEL

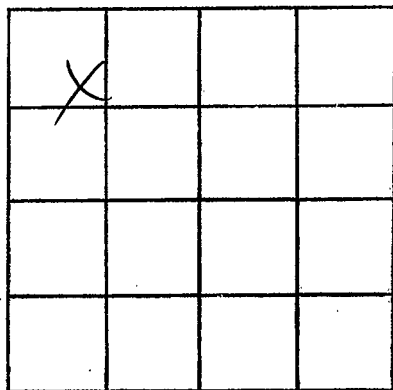

SECTION 30

Please indicate well location X.

ADDITIONAL INFORMATION

If more than one screen,  
show locations of each on sketch.