

MISSISSIPPI DEPARTMENT OF NATURAL RESOURCES

Bureau of Land and Water Resources

Southport Mall

P.O. Box 10631

Jackson, Mississippi 39209

WATER WELL DRILLERS LOG

PIKE
F 2062

1-6-86 1986
date well completed

F. J. Smallwell, Inc.
firm name

Pike
county well located

LANDOWNER:	description of formations encountered	from	to
<u>Wilbert Gayden</u> <u>RR. 3, Tipton, ms.</u> (mailing address)	<u>Red Clay</u> <u>Red Sand</u> <u>Coarse sand & gravel</u>	<u>0</u> <u>20</u> <u>150</u>	<u>20</u> <u>150</u> <u>165</u>
<p>WELL LOCATION:</p> <p>sec. <u>23</u> T-<u>3</u> N R-<u>9</u> E S W</p> <p><u>4</u> miles <u>E</u> of <u>Holmesville</u> (distance) (direction) (nearest town)</p>			
<p>WELL PURPOSE: <u>Home</u> (home, irrigation, municipal, industrial)</p>			
<p>WELL COMPLETION DATA:</p> <p>(1) diameter (inches) <u>4</u></p> <p>(2) total depth (feet) <u>165</u></p> <p>(3) static water level (feet) <u>110</u> below above top of ground.</p> <p>(4) casing <u>PVC</u>, <u>155</u>, (material) (depth) <u>4</u> (size) if telescope see back.</p> <p>(5) screen <u>10</u>, <u>155</u> (length) (depth to top) <u>4</u>, <u>PVC</u> (size) (material)</p> <p>(6) pump <u>1/2</u>, <u>10</u> (HP) (yield gpm) <u>Electric</u> (type power)</p> <p>(7) electric log <u>no</u> (yes or no) <u>no</u> (organization running log)</p> <p>(8) how well bottom plugged <u>Seal block</u></p>			


RECEIVED
JAN 30 1986

DRILLERS REMARKS:

Department of Natural Resources
Bureau of Land & Water Resources

If well telescopes please
sketch and show depths.

GROUND LEVEL

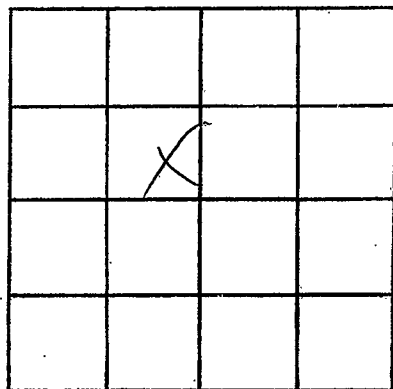

SECTION 23

Please indicate well location X.

ADDITIONAL INFORMATION

If more than one screen,
show locations of each on sketch.