

MISSISSIPPI DEPARTMENT OF NATURAL RESOURCES

Bureau of Land and Water Resources

Southport Mall

P.O. Box 10631

Jackson, Mississippi 39209

WATER WELL DRILLERS LOG

PIKE
Faulkner

Jan 24 1986 Revere Well Dr Pike
 date well completed firm name county well located


LANDOWNER:
Georgia Bullock
Rt 3 Tylitown
 (mailing address)

description of formations encountered	from	to
clay	2	18
sand & gravel	18	46
white chalk	46	110
brown sand	110	125
pea gravel & sand	125	140

WELL LOCATION:
 sec. 14 T 3 N R 9 E
12 miles east of Mt. Carmel
 (distance) (direction) (nearest town)

WELL PURPOSE: new house
 (home, irrigation, municipal, industrial)

- WELL COMPLETION DATA:
- (1) diameter (inches) 4"
 - (2) total depth (feet) 140
 - (3) static water level (feet) 82 below top of ground.
 - (4) casing plastic (material), bottom (depth)
 - (size) if telescope see back.
 - (5) screen 5' (length), 125' (depth to top)
 - (size) 4" (material) plastic
 - (6) pump 1/2 (HP), 10 (yield gpm)
 - (type power) shot
 - (7) electric log no (yes or no)
 - (organization running log)
 - (8) how well bottom plugged back wash

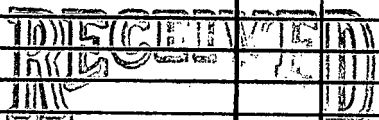

JUL 01 1986

Department of Natural Resources
 Bureau of Land & Water Resources

DRILLERS REMARKS:

If well telescopes please sketch and show depths.

GROUND LEVEL

X			

SECTION 14

Please indicate well location X.

ADDITIONAL INFORMATION

If more than one screen, show locations of each on sketch.