

MISSISSIPPI DEPARTMENT OF NATURAL RESOURCES

Bureau of Land and Water Resources

Southport Mall

P.O. Box 10631

Jackson, Mississippi 39209

WATER WELL DRILLERS LOG

PIKE
F 200

12-4

19


86 Fitzgerald Well Serv

Pike

date well completed


firm name

county well located

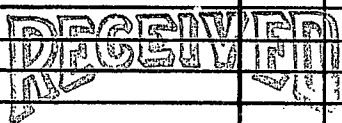LANDOWNER:	description of formations encountered	from	to
Richard Barr	River Gravel	0	15
RR. 2, McComb, Ms.	White chalk	15	105
(mailing address)	Coarse sand & gravel	105	121
WELL LOCATION:			
sec. 28 T. 3 N R. 9 E S W			
8 miles E of McComb (distance) (direction) (nearest town)			
WELL PURPOSE: Home (home, irrigation, municipal, industrial)			
WELL COMPLETION DATA:			
(1) diameter (inches) 4			
(2) total depth (feet) 121			
(3) static water level (feet) +5 below top of ground. above			
(4) casing PVC, 111, (material) (depth) 4 (size) if telescope see back.			
(5) screen 10, 111 (length) (depth to top)			
(6) pump 4, PVC (size) (material) 1/2 10 (HP) (yield gpm)			
(7) electric log No (yes or no)			
(organization running log)			
(8) how well bottom plugged Sand Shark			
DRILLERS REMARKS:			
 FEB 12 1987			

If well telescopes please sketch and show depths.

GROUND LEVEL

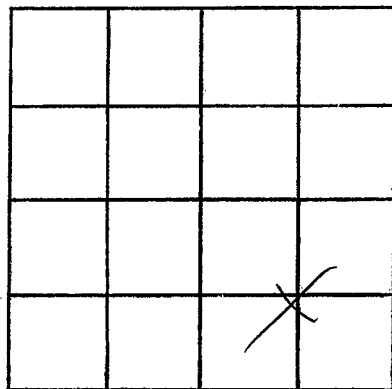

SECTION 28

Please indicate well location X.

ADDITIONAL INFORMATION

If more than one screen,
show locations of each on sketch.