

PIKE
F 2012

MISSISSIPPI DEPARTMENT OF NATURAL RESOURCES
Bureau of Land and Water Resources
Southport Mall
P.O. Box 10631
Jackson, Mississippi 39209
WATER WELL DRILLERS LOG

1-27 1987 Fitzgerald Well Sew Pike
date well completed firm name county well located

LANDOWNER:
Dennis Leonard
R.R. 3 Holmsville, Miss.
(mailing address)

description of formations encountered	from	to
	<u>Red clay</u>	<u>0</u>
<u>Red sand</u>	<u>20</u>	<u>132</u>
<u>Coarse sand & gravel</u>	<u>132</u>	<u>150</u>

WELL LOCATION:
sec. 23 T 3 N R 9 E
S W
3 miles E of Holmsville
(distance) (direction) (nearest town)

WELL PURPOSE: Home
(home, irrigation, municipal, industrial)

- WELL COMPLETION DATA:
- (1) diameter (inches) 4
 - (2) total depth (feet) 150
 - (3) static water level (feet) 100 below above top of ground.
 - (4) casing PVC, 140,
(material) (depth)
4
(size) if telescope see back.
 - (5) screen 10, 100
(length) (depth to top)
4, PVC
(size) (material)
 - (6) pump 1/2 10
(HP) (yield gpm)
Electric
(type power)
 - (7) electric log no
(yes or no)
(organization running log)
 - (8) how well bottom plugged Sealed

RECEIVED


FEB 12 1987

Department of Natural Resources
Bureau of Land & Water Resources

DRILLERS REMARKS:

If well telescopes please sketch and show depths.

GROUND LEVEL

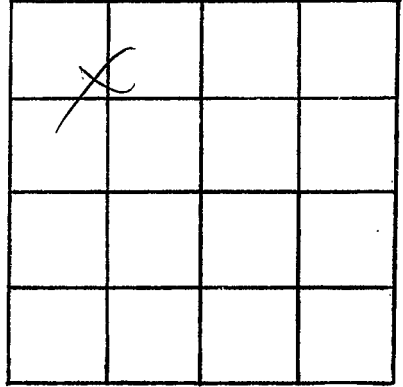

SECTION 23

Please indicate well location X.

ADDITIONAL INFORMATION

If more than one screen, show locations of each on sketch.