

MISSISSIPPI DEPARTMENT OF NATURAL RESOURCES

Bureau of Land and Water Resources

Southport Mall

P.O. Box 10631

Jackson, Mississippi 39209

WATER WELL DRILLERS LOG

PIKE
F 2073

Feb 3

1987

F. Howell Sewell Sew

Pike

date well completed

firm name

county well located

LANDOWNER:	description of formations encountered	from	to
<i>General McBride</i>			
<i>P.R. 2, McComb, Ms.</i> (mailing address)	<i>Red clay</i> <i>fine sand to gravel</i> <i>coarse sand to gravel</i>	<i>0</i> <i>20</i> <i>80</i>	<i>20</i> <i>80</i> <i>95</i>
WELL LOCATION:			
sec. <i>32</i> T. <i>3</i> N. R. <i>9</i> E S W			
<i>8</i> miles <i>E</i> of <i>McComb</i> (distance) (direction) (nearest town)			
WELL PURPOSE: <i>Home</i> (home, irrigation, municipal, industrial)			
WELL COMPLETION DATA:			
(1) diameter (inches) <i>4</i>			
(2) total depth (feet) <i>95</i>			
(3) static water level (feet) <i>15</i> below top of ground. above			
(4) casing <i>PVC</i> , <i>85</i> (material) (depth) <i>4</i> (size) if telescope see back.			
(5) screen <i>10</i> , <i>85</i> (length) (depth to top)			
<i>4</i> , <i>PVC</i> (size) (material)			
(6) pump <i>1/2</i> , <i>10</i> (HP) (yield gpm)			
<i>Electric</i> (type power)			
(7) electric log <i>no</i> (yes or no)			
<i>General Sewell</i> (organization running log)			
(8) how well bottom plugged <i>Good</i>			
DRILLERS REMARKS:			


RECEIVED

FEB 12 1987

Department of Natural Resources
Bureau of Land & Water Resources

If well telescopes please sketch and show depths.

GROUND LEVEL

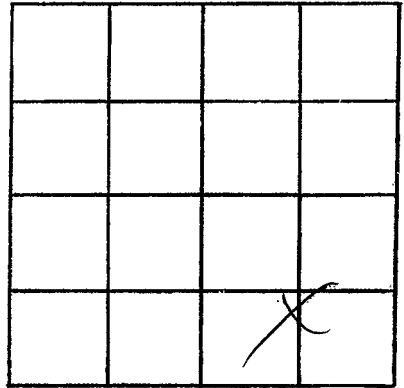

SECTION 32

Please indicate well location X.

ADDITIONAL INFORMATION

If more than one screen,
show locations of each on sketch.