

MISSISSIPPI DEPARTMENT OF NATURAL RESOURCES

Bureau of Land and Water Resources

Southport Mall

P.O. Box 10631

Jackson, Mississippi 39209

WATER WELL DRILLERS LOG

PIKE  
F 2074

Feb 22 1987  
date well completed

Fitzgerald Well Service  
firm name

Pike  
county well located

LANDOWNER:	description of formations encountered	from	to
3-M - Sawmill			
P.R. 2, McComb, ms. (mailing address)	Red clay Blue chalk Cave sand & gravel	0 10 14	20 74 88
<b>WELL LOCATION:</b>			
sec 35 T 3 N R 9 E S W			
12 miles E of McComb (distance) (direction) (nearest town)			
<b>WELL PURPOSE:</b> OFFICE & POND (home, irrigation, municipal, industrial)			
<b>WELL COMPLETION DATA:</b>			
(1) diameter (inches) 4			
(2) total depth (feet) 88			
(3) static water level (feet) 5 below top of ground.			
(4) casing PVC, 78 (material) (depth)			
4 if telescope see back. (size)			
(5) screen 10, 78 (length) (depth to top)			
4, PVC (size) (material)			
(6) pump 1, 20 (HP) (yield gpm)			
elec (type power)			
(7) electric log No (yes or no)			
(organization running log)			
(8) how well bottom plugged Seal (organization running log)			

RECEIVED


MAR 20 1987

Department of Natural Resources  
Bureau of Land & Water Resources

DRILLERS REMARKS:

If well telescopes please sketch and show depths.

GROUND LEVEL

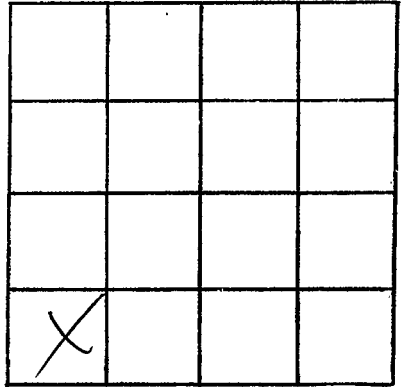

SECTION 35

Please indicate well location X.

ADDITIONAL INFORMATION

If more than one screen,  
show locations of each on sketch.