

**MISSISSIPPI DEPARTMENT OF NATURAL RESOURCES**  
 Bureau of Land and Water Resources  
 Southport Mall  
 P.O. Box 10631  
 Jackson, Mississippi 39209  
**WATER WELL DRILLERS LOG**

PIKE  
F 2005

8-12 1987 Fitzgerald Well Serv Pike  
 date well completed firm name county well located

**LANDOWNER:**  
Oliver Smith  
R.R. 3, Lytle  
 (mailing address)

description of formations encountered	from	to
	<u>Red clay</u>	<u>0</u>
<u>white &amp; blue clay</u>	<u>20</u>	<u>138</u>
<u>Coarse sand &amp; gravel</u>	<u>138</u>	<u>156</u>

**WELL LOCATION:**  
 sec. 11 T. 3 N R. 9 E  
 S W  
3 miles S of Pinola  
 (distance) (direction) (nearest town)

**WELL PURPOSE:** Home  
 (home, irrigation, municipal, industrial)

- WELL COMPLETION DATA:**
- diameter (inches) 4
  - total depth (feet) 156
  - static water level (feet) 65 below above top of ground.
  - casing 4 (material) 146 (depth)  
4 (size) if telescope see back.
  - screen 10 (length) 146 (depth to top)  
4 (size) 40 (material)
  - pump 1/2 (HP) 10 (yield gpm)  
Elco (type power)
  - electric log No (yes or no)  
 (organization running log)
  - how well bottom plugged Sand plug

**RECEIVED**


AUG 27 1987

Department of Natural Resources  
 Bureau of Land & Water Resources

**DRILLERS REMARKS:**

If well telescopes please sketch and show depths.

GROUND LEVEL

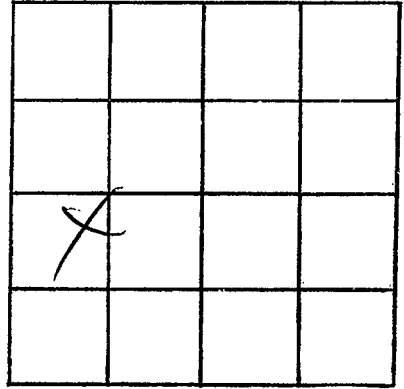

SECTION 11

Please indicate well location X.

ADDITIONAL INFORMATION

If more than one screen,  
show locations of each on sketch.