

Bureau of Land and Water Resources

Jackson, Mississippi 39209

WATER WELL DRILLERS LOG

COUNTY WELL LOCATED	
<i>Pike</i>	
WELL NUMBER	CODED
F	
<i>2072</i>	
DATE WELL COMPLETED	

PERMIT NUMBER

NAME OF DRILLING FIRM
F. J. General well Inc

NAME & MAILING ADDRESS OF LANDOWNER

Mary Conant
Rt 3, Lytleton mo

WELL LOCATION: SEC TOWNSHIP RANGE

3 3 N 9 E
S S W

DISTANCE DIRECTION NEAREST TOWN

3 S of Pinedale

Miles of

OTHER LANDMARK

Home

WELL PURPOSE: Home, Irrigation, Municipal, Industrial, Fish Pond, etc.

PUMP DATA			
PUMP TYPE (Circle One):			
Submersible	Turbine,	Jet	Flowing Well,
Other (Describe) _____			
POWER TYPE (Circle One):			
<u>Electric</u>	Tractor,	Diesel,	Gasoline, Butane,
Other (Describe) _____			

Pump Capacity (GPM)	No. of Stages	Setting Depth
10	10	85 FT.

PUMP TEST

Well yielded 25 GPM with


a drawdown of 2 ft.

after 1 hours of pumping

WELL DATA		
Well Depth 150	Casing Diameter (In.) 4	Casing Length (Ft.) 140
Type of Casing PVC	Hole Depth 150	Depth to Static Water Level 63
TYPE OF COMPLETION: (Circle One or More):		
<input checked="" type="checkbox"/> Gravel Packed,	<input type="checkbox"/> Underreamed,	<input type="checkbox"/> Telescoped,
<input checked="" type="checkbox"/> Natural Development,	<input type="checkbox"/> Open Hole,	<input type="checkbox"/> Other
(Describe) _____		
Top of Lap Pipe or Reduction in Casing		
<div>FEET</div> <div>IF TELESCOPED OR MORE THAN ONE SCREEN: USE BACK PAGE</div>		

LOG DATA

TYPE OF LOG RUN (Circle One): Electric, Gamma Ray, Density, Sonic, Neutron, Other (Describe) _____	No Log Run,
Name of Organization Running Log _____	




SCREEN DATA		
Diameter - Inches 4	Length - Feet 10	Slot Size - Inches 10/4
Screen Type MCL		Depth to Bottom - Feet 150

GEOLOGIC DATA (A Office Use Only)			
Surface Elev.	Geologic Unit	Unit Thickness	Depth to Top
Subs. SWL	Date	Analysis	Aquifer Test
Driller's Remarks			

[illegible]

If well telescopes please
sketch and show depths.

GROUND LEVEL

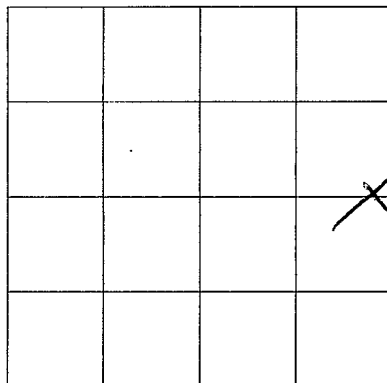

SECTION 3

Please indicate well location X.

ADDITIONAL INFORMATION

If more than one screen,
show location of each on sketch.