

MISSISSIPPI DEPARTMENT OF NATURAL RESOURCES

Bureau of Land and Water Resources

P.O. Box 10631

Jackson, Mississippi 39209

WATER WELL DRILLERS LOG

COUNTY WELL LOCATED	
<i>Dike</i>	
WELL NUMBER	CODED
<i>F</i>	
2080	
DATE WELL COMPLETED	
5-27-88	

PERMIT NUMBER
NAME OF DRILLING FIRM
<i>FITZGERALD Well Serv</i>

NAME & MAILING ADDRESS OF LANDOWNER			
<i>James Gathin</i>			
<i>R.R. 2, McComb, MS.</i>			
WELL LOCATION: SEC	TOWNSHIP	RANGE	
<i>31</i>	<i>3</i>	<i>N</i>	<i>E</i>
		<i>S</i>	<i>9</i>
DISTANCE	DIRECTION	NEAREST TOWN	
<i>7</i> Miles	<i>E</i>	<i>McComb</i>	
OTHER LANDMARK			
WELL PURPOSE: Home, Irrigation, Municipal, Industrial, Fish Pond, etc.			
<i>Home</i>			

PUMP DATA			
PUMP TYPE (Circle One):			
<input checked="" type="radio"/> Submersible	<input type="radio"/> Turbine	<input type="radio"/> Jet	<input type="radio"/> Flowing Well
Other (Describe) _____			
POWER TYPE (Circle One):			
<input checked="" type="radio"/> Electric	<input type="radio"/> Tractor	<input type="radio"/> Diesel	<input type="radio"/> Gasoline
Other (Describe) _____			
Pump Capacity (GPM)	No. of Stages	Setting Depth	
<i>10</i>	<i>10</i>	<i>80</i> FT.	
PUMP TEST			
Well yielded <i>10</i> GPM with			
a drawdown of <i>10</i> ft.			
after <i>2</i> hours of pumping			

WELL DATA		
Well Depth	Casing Diameter (In.)	Casing Length (Ft.)
<i>130</i>	<i>4</i>	<i>120</i>
Type of Casing	Hole Depth	Depth to Static Water Level
<i>pu</i>	<i>130</i>	<i>36</i>
TYPE OF COMPLETION: (Circle One or More):		
<input checked="" type="radio"/> Gravel Packed	<input type="radio"/> Underreamed,	<input type="radio"/> Telescoped,
<input type="radio"/> Natural Development,	<input type="radio"/> Open Hole,	<input type="radio"/> Other
(Describe) _____		
Top of Lap Pipe or Reduction in Casing		
. FEET		
IF TELESCOPED OR MORE THAN ONE SCREEN: USE BACK PAGE		

LOG DATA	
TYPE OF LOG RUN (Circle One):	
<input type="radio"/> Electric,	<input type="radio"/> Gamma Ray,
<input type="radio"/> Density,	<input type="radio"/> Sonic,
<input type="radio"/> Other (Describe) _____	<input checked="" type="radio"/> No Log Run
Name of Organization Running Log	

SCREEN DATA		
Diameter - Inches	Length - Feet	Slot Size - Inches
<i>4</i>	<i>10</i>	<i>1/16</i>
Screen Type	Depth to Bottom - Feet	
<i>pu</i>	<i>130</i>	


GEOLOGIC DATA (Office Use Only)			
Surface Elev.	Geologic Unit	Unit Thickness	Depth to Top
Subs. SWL	Date	Analysis	Aquifer Test
Driller's Remarks			

DESCRIPTION OF FORMATIONS ENCOUNTERED	FROM	TO	FORMATIONS (Continued)	FROM	TO
<i>Red Clay</i>	<i>6</i>	<i>20</i>	<div style="font-size: 2em; font-weight: bold; opacity: 0.5;">RECEIVED</div> <div style="font-size: 1.5em; font-weight: bold; margin-top: 10px;">JUN 28 1988</div> <div style="font-size: 0.8em; margin-top: 20px;"> Department of Natural Resources Bureau of Land & Water Resources </div>		
<i>Red Sand</i>	<i>20</i>	<i>110</i>			
<i>Coarse Sand & gravel</i>	<i>110</i>	<i>130</i>			

IF MORE SPACE IS NEEDED, USE BACK

If well telescopes please sketch and show depths.

GROUND LEVEL

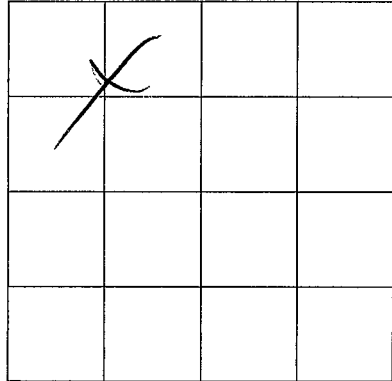

SECTION 31

Please indicate well location X.

ADDITIONAL INFORMATION

Lined area for additional information.

If more than one screen, show location of each on sketch.