

MISSISSIPPI DEPARTMENT OF NATURAL RESOURCES

Bureau of Land and Water Resources

COUNTY WELL LOCATED <i>Pike</i>	
WELL NUMBER <i>F</i>	CODED
DATE WELL COMPLETED <i>2085</i> <i>3-20-89</i>	

PERMIT NUMBER
NAME OF BILLING FIRM <i>F. S. Small Well Serv</i>

P.O. Box 10631
Jackson, Mississippi 39209
WATER WELL DRILLERS LOG

NAME & MAILING ADDRESS OF LANDOWNER <i>J. C. Dillon</i>			
<i>RR 1 Summit ms.</i>			
WELL LOCATION: SEC	TOWNSHIP	RANGE	
<i>5</i>	<i>3</i>	<i>N</i>	<i>9</i>
	<i>S</i>	<i>E</i>	<i>W</i>
DISTANCE	DIRECTION	NEAREST TOWN	
<i>2</i> Miles	<i>SW</i>	<i>Pinedale</i>	
OTHER LANDMARK			
WELL PURPOSE: Home, Irrigation, Municipal, Industrial, Fish Pond, etc. <i>Home</i>			

PUMP DATA		
PUMP TYPE (Circle One): <u>Submersible</u> Turbine, Jet, Flowing Well, Other (Describe) _____		
POWER TYPE (Circle One): <u>Electric</u> , Tractor, Diesel, Gasoline, Butane, Other (Describe) _____		
Pump Capacity (GPM)	No. of Stages	Setting Depth
<i>10</i>	<i>9</i>	<i>120</i> FT.
PUMP TEST		
Well yielded <i>10</i> GPM with		
a drawdown of <i>4</i> ft.		
after <i>2</i> hours of pumping		

WELL DATA		
Well Depth <i>145</i>	Casing Diameter (In.) <i>4</i>	Casing Length (Ft.) <i>135</i>
Type of Casing <i>PVC</i>	Hole Depth <i>145</i>	Depth to Static Water Level <i>92</i>
TYPE OF COMPLETION: (Circle One or More): <u>Gravel Packed</u> , Underreamed, Telescoped, Natural Development, Open Hole, Other (Describe) _____		
Top of Lap Pipe or Reduction in Casing		
FEET	IF TELESCOPED OR MORE THAN ONE SCREEN: USE BACK PAGE	

LOG DATA	
TYPE OF LOG RUN (Circle One): Electric, Gamma Ray, Density, Sonic, Neutron, Other (Describe) _____	
<u>No Log Run</u>	
Name of Organization Running Log	

SCREEN DATA		
Diameter - Inches <i>4</i>	Length - Feet <i>10</i>	Slot Size - Inches <i>10/16</i>
Screen Type <i>PVC</i>		Depth to Bottom - Feet <i>145</i>

GEOLOGIC DATA (Office Use Only)			
Surface Elev.	Geologic Unit	Unit Thickness	Depth to Top
Subs. SWL	Date	Analysis	Aquifer Test


Driller's Remarks
<i>RECEIVED</i>
<i>APR 20 1989</i>

DESCRIPTION OF FORMATIONS ENCOUNTERED	FROM	TO	FORMATIONS (Continued on back)	FROM	TO
<i>Red clay</i>	<i>0</i>	<i>20</i>	<i>Continued on back</i>		
<i>Red sand</i>	<i>20</i>	<i>70</i>	<i>Continued on back</i>		
<i>Red gravel</i>	<i>70</i>	<i>130</i>	<i>Continued on back</i>		
<i>Course sand & gravel</i>	<i>130</i>	<i>145</i>	<i>Continued on back</i>		

IF MORE SPACE IS NEEDED, USE BACK

If well telescopes please sketch and show depths.

GROUND LEVEL

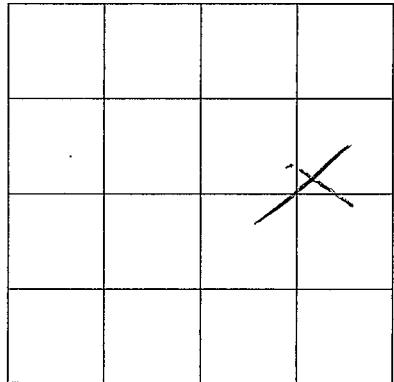

SECTION 5

Please indicate well location X.

ADDITIONAL INFORMATION

If more than one screen,
show location of each on sketch.