

MISSISSIPPI DEPARTMENT OF NATURAL RESOURCES

Bureau of Land and Water Resources

Southport Mall

P.O. Box 10631

Jackson, Mississippi 39209

WATER WELL DRILLERS LOG

PIKE
F 2089

Nov 10 1989 Fitzgerald Well Serv Pike
 date well completed firm name county well located

LANDOWNER:	description of formations encountered	from	to
<u>Leary Magee</u> <u>Rd. 1, Summit ms.</u> (mailing address)			
WELL LOCATION:			
sec. <u>3</u> -T- <u>3</u> N R- <u>9</u> E S W			
<u>3</u> miles <u>SW</u> of <u>Pinedale</u> (distance) (direction) (nearest town)			
WELL PURPOSE: <u>Home</u> (home, irrigation, municipal, industrial)			
WELL COMPLETION DATA:			
(1) diameter (inches) <u>4</u>			
(2) total depth (feet) <u>146</u>			
(3) static water level (feet) <u>77</u> below top of ground.			
(4) casing <u>PVC</u> <u>136</u> (material) (depth)			
<u>4</u> (size) if telescope see back.			
(5) screen <u>10</u> <u>136</u> (length) (depth to top)			
<u>4</u> <u>PVC</u> (size) (material)			
(6) pump <u>1/2</u> <u>10</u> (HP) (yield gpm)			
<u>elec</u> (type power)			
(7) electric log <u>No</u> (yes or no)			
<u>Smalley</u> (organization running log)			
(8) how well bottom plugged <u>Smalley</u>			
DRILLERS REMARKS:			


RECEIVED

DEC 11 1989

Department of Natural Resources
 Bureau of Land & Water Resources

If well telescopes please sketch and show depths.

GROUND LEVEL

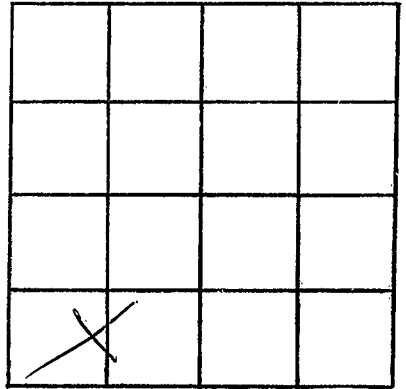

SECTION

3

Please indicate well location X.

ADDITIONAL INFORMATION

If more than one screen,
show locations of each on sketch.