

MISSISSIPPI DEPARTMENT OF NATURAL RESOURCES

Bureau of Land and Water Resources

Southport Mall

P.O. Box 10631

Jackson, Mississippi 39209

WATER WELL DRILLERS LOG

PIRE
F
2092

July 9 1926 *Fitzgerald Well Serv* Pire
 date well completed firm name county well located

LANDOWNER:	description of formations encountered	from	to
<i>Cedro Barnes -</i>			
<i>R.R. McComb, Jr. 1</i> (mailing address)	<i>Red clay</i>	<i>0</i>	<i>20</i>
	<i>Red sand</i>	<i>20</i>	<i>75</i>
	<i>White clay</i>	<i>75</i>	<i>155</i>
	<i>Coarse sand & gravel</i>	<i>155</i>	<i>167</i>
WELL LOCATION:			
sec. <i>33</i> T <i>3</i> N R <i>9</i> E S W			
<i>8</i> miles <i>E</i> of <i>McComb</i> (distance) (direction) (nearest town)			
WELL PURPOSE: <i>Home</i> (home, irrigation, municipal, industrial)			
WELL COMPLETION DATA:			
(1) diameter (inches) <i>4</i>			
(2) total depth (feet) <i>167</i>			
(3) static water level (feet) <i>98</i> below top of ground.			
(4) casing <i>PVC</i> <i>157</i> (material) (depth)			
<i>4</i> if telescope see back. (size)			
(5) screen <i>10</i> <i>157</i> (length) (depth to top)			
<i>4</i> <i>PVC</i> (size) (material)			
(6) pump <i>1/2</i> <i>10</i> (HP) (yield gpm)			
<i>Electric</i> (type power)			
(7) electric log <i>no</i> (yes or no)			
<i>Seal Well</i> (organization running log)			
(8) how well bottom plugged <i>Seal Well</i>			
DRILLERS REMARKS:			


RECEIVED

AUG 17 1926

Department of Natural Resources
 Bureau of Land & Water Resources

If well telescopes please sketch and show depths.

GROUND LEVEL

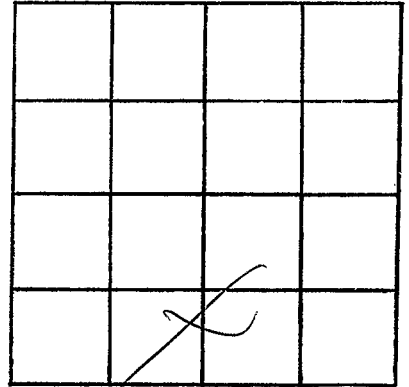

SECTION 33

Please indicate well location X.

ADDITIONAL INFORMATION

If more than one screen,
show locations of each on sketch.