

**MISSISSIPPI DEPARTMENT OF NATURAL RESOURCES**  
Bureau of Land and Water Resources

P.O. Box 10631

Jackson, Mississippi 39209

**WATER WELL DRILLERS LOG**

COUNTY WELL LOCATED <i>Field</i>	
WELL NUMBER <i>F</i>	CODED
DATE WELL COMPLETED <i>2100</i> <i>6-22-92</i>	

PERMIT NUMBER <i>287</i>
NAME OF DRILLING FIRM <i>Chester Reeves</i>

NAME & MAILING ADDRESS OF LANDOWNER <i>Keith Bramfield</i> <i>Pt 2 McComb</i>		
WELL LOCATION: SEC	TOWNSHIP	RANGE
<i>30</i>	<i>3</i>	<i>9</i>
DISTANCE	DIRECTION	NEAREST TOWN
<i>6</i> Miles	<i>east</i>	<i>of McComb</i>
OTHER LANDMARK <i>98 H-Way - east</i>		
WELL PURPOSE: Home, Irrigation, Municipal, Industrial, Fish Pond, etc.		

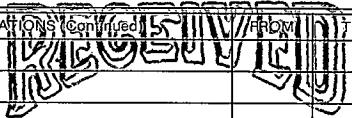
<b>PUMP DATA</b>		
PUMP TYPE (Circle One): <del>Submersible</del> , Turbine, Jet, Flowing Well, Other (Describe) _____		
POWER TYPE (Circle One): <u>Electric</u> , Tractor, Diesel, Gasoline, Butane, Other (Describe) _____ H/P <i>3</i>		
Pump Capacity (GPM) <i>10</i>	No. of Stages <i>8</i>	Setting Depth <i>100'</i> FT.
PUMP TEST		
Well yielded <i>10</i> GPM with a drawdown of <i>none</i> ft. after <i>1/2</i> hours of pumping		

<b>WELL DATA</b>		
Well Depth <i>125'</i>	Casing Diameter (In.) <i>4"</i>	Casing Length (Ft.) <i>115'</i>
Type of Casing <i>P.V.C.</i>	Hole Depth <i>125'</i>	Depth to Static Water Level <i>98'</i>
TYPE OF COMPLETION: (Circle One or More): Gravel Packed, Underreamed, Telescoped, <u>Natural Development</u> , Open Hole, Other		
Top of Lap Pipe or Reduction in Casing		
FEET	IF TELESCOPED OR MORE THAN ONE SCREEN: USE BACK PAGE	

<b>LOG DATA</b>	
TYPE OF LOG RUN: (Circle One): Electric, Gamma Ray, Density, Sonic, <u>No Log Run</u> , Neutron, Other (Describe) _____	
Name of Organization Running Log	

<b>SCREEN DATA</b>		
Diameter - Inches <i>4"</i>	Length - Feet <i>10'</i>	Slot Size - Inches <i>010</i>
Screen Type <i>P.V.C.</i>	Depth to Bottom - Feet <i>125'</i>	

<b>GEOLOGIC DATA (Office Use Only)</b>			
Surface Elev.	Geologic Unit	Unit Thickness	Depth to Top
Subs. SWL	Date	Analysis	Aquifer Test
Driller's Remarks			

DESCRIPTION OF FORMATIONS ENCOUNTERED	FROM	TO	FORMATIONS (Continued)	FROM	TO
<i>Clay &amp; Gravel</i>	<i>0</i>	<i>18</i>	 <b>JUL 01 1992</b> Dept. of Environmental Quality Bureau of Land & Water Resources		
<i>Medium sand</i>	<i>18</i>	<i>70</i>			
<i>Chalk sand &amp; gravel</i>	<i>70</i>	<i>110</i>			
<i>Small gravel &amp; sand</i>	<i>110</i>	<i>125</i>			

IF MORE SPACE IS NEEDED, USE BACK

If well telescopes please sketch and show depths.

GROUND LEVEL


SECTION 30

Please indicate well location X.

ADDITIONAL INFORMATION

If more than one screen,  
show location of each on sketch.