

MISSISSIPPI DEPARTMENT OF ENVIRONMENTAL QUALITY

Office of Land and Water Resources

P. O. Box 10631
Jackson, MS 39289-0631
WATER WELL DRILLERS LOG

COUNTY WELL LOCATED <i>Pike</i>	
WELL NUMBER <i>F 103</i>	CODED
DATE WELL COMPLETED <i>October 12 92</i>	

PERMIT NUMBER
NAME OF DRILLING FIRM <i>FitzGERMUN Well Serv</i>

NAME & MAILING ADDRESS OF LANDOWNER <i>Tom Rochelle</i>			
<i>RR. McComb, MS</i>			
WELL LOCATION:	SEC	TOWNSHIP	RANGE
	<i>21</i>	<i>3</i>	<i>N 9 E</i>
DISTANCE	DIRECTION	NEAREST TOWN	
<i>1</i> Miles	<i>E</i>	of <i>Holmesville</i>	
OTHER LANDMARK			
WELL PURPOSE: Home, Irrigation, Municipal, Industrial, Fish Pond, etc. <i>Home</i>			

PUMP DATA		
PUMP TYPE (Circle One): Submersible, Turbine, Jet, Flowing Well, Other (Describe) _____		
POWER TYPE (Circle One): Electric, Tractor, Diesel, Gasoline, Butane, Other (Describe) _____ H/P <i>21</i>		
Pump Capacity (GPM)	No. of Stages	Setting Depth
<i>20</i>	<i>10</i>	<i>80</i> FT.
PUMP TEST		
Well yielded <i>25</i> GPM with a drawdown of <i>3</i> ft. after <i>2</i> hours of pumping		

WELL DATA		
Well Depth <i>95</i>	Casing Diameter (In.) <i>4</i>	Casing Length (Ft.) <i>85</i>
Type of Casing <i>N/C</i>	Hole Depth <i>95</i>	Depth to Static Water Level <i>15</i>

LOG DATA	
TYPE OF LOG RUN (Circle One): Electric, Gamma Ray, Density, Sonic, Neutron, Other (Describe) _____	
Name of Organization Running Log	

TYPE OF COMPLETION: (Circle One or More):
Gravel Packed, Underreamed, Telescoped,
 Natural Development, Open Hole, Other

WELL GROUTED TO A DEPTH OF *10* FEET
Type Grout (circle one): Cement, Bentonite, or Mix

GEOLOGIC DATA (Office Use Only)			
Surface Elev.	Geologic Unit	Unit Thickness	Depth to Top
Subs. SWL	Date	Analysis	Aquifer Test

SCREEN DATA		
Diameter - Inches <i>4</i>	Length - Feet <i>10</i>	Slot Size - Inches <i>10/14</i>
Screen Type <i>N/C</i>	Depth to Bottom - Feet <i>95</i>	

Driller's Remarks


DESCRIPTION OF FORMATIONS ENCOUNTERED	FROM	TO
<i>Red Clay</i>	<i>0</i>	<i>10</i>
<i>Red Sand</i>	<i>20</i>	<i>80</i>
<i>Coarse Sand</i>	<i>80</i>	<i>95</i>

FORMATIONS (Continued)	FROM	TO
RECEIVED		
DEC 07 1992		
Dept. of Environmental Quality Bureau of Land & Water Resources		

IF MORE SPACE IS NEEDED, USE BACK

If well telescopes please sketch and show depths.

GROUND LEVEL

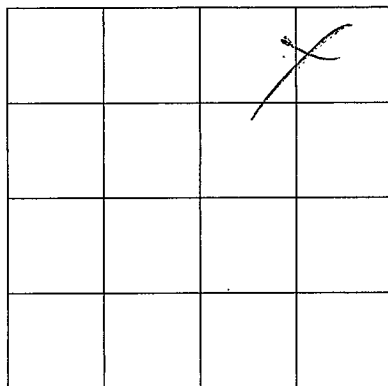

SECTION 2/

Please indicate well location X.

ADDITIONAL INFORMATION

If more than one screen,
show location of each on sketch.